

HOLMES MISSISSIPPI BOARD OF WATER COMMISSIONERS

T 3
12-17-63

WATER WELL DRILLERS LOG

CODED

Holmes

Date: 12/17, 1963, Driller: Just Drilling Ser County: Scott
(Name)

(1) Owner of Land: A. B. Killings
(Name)

Quarant, Miss
(Address)

(2) Location: 1/4, 1/4, Sec. 12 T. 14 R. 95

2 miles North of Quarant
(distance) (direction) (Nearest Town)

(3) Topography: X (Hilly) X (Flat) (Level)

(4) Purpose of Well: Chicken
(Domestic Irrigation, Municipal, Industrial, Other)

Description & Color of Materials Sand, Clay, Red Clay, Shell, etc.	Thick- ness Feet	Depth Feet
Brown Clay		15
Blue Clay		20
Sand		100
Clay + Sths Sand		122
Clay		143
Sand		163
Coarse Sand		184
Blue Clay		230
Clay + Rock		266
Shale, sand + Lime		340
Sand + Sths Shale		348
Shale + Sths Sand		410
Shale + Sths Rock		500
Shale + Sths Sand		574
Fine Sand		525
Shale		565
Fine Sand + Sths		575
Sand + Shale		580
Shale		595
Fine Sand		620

Information upon completion of well:

(1) Diameter 2 inches.

(2) Total Depth 620 feet.

(3) Water Level Flowing Well feet below top of ground.

(4) Cased to 615, Size 2


(5) Screen: Size 3" AD, Length 15 ft

(6) Were any formations sealed against pollution?
yes, X no.

If YES depth of formation _____

Why _____

Drillers Remarks: _____

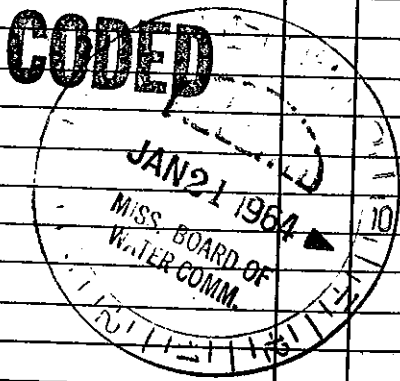

Well No. _____

(Use Back Side)