

HOLMES MISSISSIPPI

T27

1-6-62

WATER WELL DRILLERS LOG

0093

Date: Jan 6, 1962, Driller: Braswell Dily Co County, Holmes

(Name)

(1) Owner of Land:	Description & Color of Materials Sand, Clay, Red Clay, Shell, etc.	Thick- ness Feet	Depth Feet
Blanton Smith (Name) Durant Hatchery (Address) Miss. 5 14th St	Sand from top to bottom		100
(2) Location: Location			
1 miles West of Durant (distance) (direction) (Nearest Town)			
(3) Topography: Hilly (Hilly) (Flat) (Level)			
(4) Purpose of Well: Industrial (Domestic Irrigation Municipal, Industrial, Other)			


Information upon completion of well:

- (1) Diameter 3 inches.
- (2) Total Depth 100 feet.
- (3) Water Level 60 feet below top of ground.
- (4) Cased to 100, Size 3
- (5) Screen: Size 2", Length 10'
- (6) Were any formations sealed against pollution?
_____ yes, _____ no.

If YES depth of formation _____

Why _____

Drillers Remarks: _____

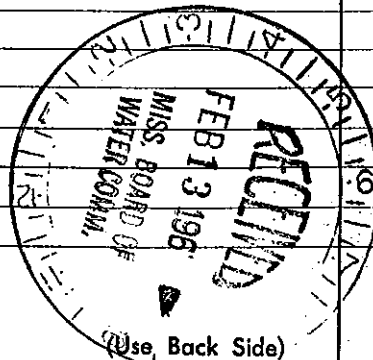

Well No.

Mail this copy to Board of Water Commissioners 429 Miss. St. Jackson, Miss