

HOLMES
T 35

MISSISSIPPI BOARD OF WATER COMMISSIONERS

BL 00728

11-23-65

WATER WELL DRILLERS LOG

CODED

Date: 11/23, 1965, Driller: Bailey Drlg. Co. County: Washington

	Description & Color of Materials Sand, Clay, Red Clay, Shell, etc.	Thick- ness Feet	Depth Feet
(1) Owner of Land: <u>Catholic Community</u>	<u>Clay</u>		<u>17</u>
(Address) <u>Durant, Miss.</u>	<u>Sand</u>		<u>210</u>
(2) Location: <u>NW 1/4 SW 1/4</u> Sec. <u>9</u> T <u>4</u> R <u>9E</u>	<u>Mud</u>		<u>250</u>
<u>2 1/2</u> miles <u>W</u> of <u>Durant</u>	<u>Sand</u>		<u>350</u>
(distance) (direction) (Nearest Town)	<u>Mud</u>		<u>606</u>
(3) Topography: <u>Hilly</u>	<u>Rock</u>		<u>607</u>
(Level)	<u>Mud</u>		<u>750</u>
(4) Purpose of Well: <u>Domestic</u>	<u>Sand</u>		<u>820</u>
(Domestic Irrigation Municipal, Industrial, Other)			

CODED


Information upon completion of well:

- (1) Diameter 6x4 inches.
- (2) Total Depth 820 feet.
- (3) Water Level 80 feet below top of ground.
- (4) Cased to all way Size 6x4.
- (5) Screen: Size 4, Length 30 ft.
- (6) Were any formations sealed against pollution?
 yes, no.

If YES depth of formation _____

Why _____

Drillers Remarks: _____

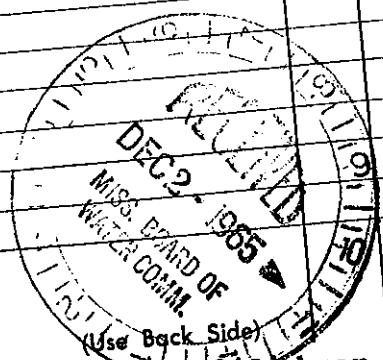

Well No. _____

Mail this copy to Board of Water Commissioners 429 Miss. St., Jackson, Miss.