

HOLMES
T39
2-64

MISSISSIPPI BOARD OF WATER COMMISSIONERS

WATER WELL DRILLERS LOG

CODED

Date: Feb, 1964, Driller: Jack Martin County: Holmes
(Name)

(1) Owner of Land: Mrs Irene Hutchinson
(Name)
Durant
(Address)

(2) Location: NW 1/4, NW 1/4, Sec. 2, T14R4E
1 miles NW of Durant
(distance) (direction) (Nearest Town)

(3) Topography: Hilly
(Hilly) (Flat) (Level)

(4) Purpose of Well: Domestic
(Domestic Irrigation
Municipal, Industrial, Other)

Description & Color of Materials Sand, Clay, Red Clay, Shell, etc.	Thick- ness Feet	Depth Feet
<u>Clay</u>	<u>12</u>	<u>12</u>
<u>Red sand</u>	<u>46</u>	<u>58</u>
<u>Sand</u>	<u>52</u>	<u>110</u>
<u>CODED</u>		

Information upon completion of well:

(1) Diameter 2 inches.

(2) Total Depth 110 feet.

(3) Water Level 73 feet below top of ground.

(4) Cased to 105', Size 2


(5) Screen: Size 2", Length 5'

(6) Were any formations sealed against pollution?
_____ yes, _____ no.

If YES depth of formation _____

Why _____

Drillers Remarks: _____

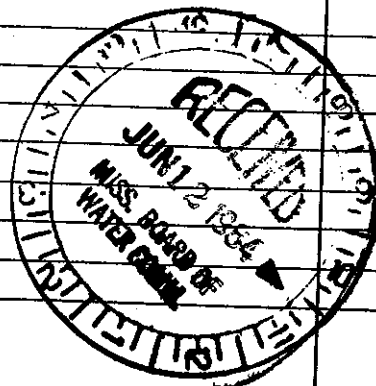

(Use Back Side)

Well No.

Mail this copy to Board of Water Commissioners 429 Miss. St. Jackson, Miss.