

HOLMES
T40
5-64

MISSISSIPPI BOARD OF WATER COMMISSIONERS
CODED

WATER WELL DRILLERS LOG

Date: May, 1964, Driller: Jack Martin County: Holmes
(Name)

(1) Owner of Land:	Description & Color of Materials Sand, Clay, Red Clay, Shell, etc.	Thick- ness Feet	Depth Feet
<u>Ward Montgomery</u> (Name) <u>Durant</u> (Address)	<u>Clay</u>	<u>14</u>	<u>14</u>
(2) Location: <u>SW 1/4, SE 1/4, Sec. 7 T14R4E</u>	<u>Sand</u>	<u>9</u>	<u>23</u>
<u>4</u> miles <u>West</u> of <u>Durant</u> (distance) (direction) (Nearest Town)	<u>CODED</u> <u>rock</u>	<u>1</u>	<u>24</u>
(3) Topography: <u>Hilly</u> (Hilly) (Flat) (Level)	<u>Sand</u>	<u>40</u>	<u>64</u>
(4) Purpose of Well: <u>Domestic</u> (Domestic Irrigation Municipal, Industrial, Other)	<u>Fine Sand - Mud</u>	<u>72</u>	<u>136</u>
	<u>Sand</u>	<u>27</u>	<u>163</u>


Information upon completion of well:

- (1) Diameter 2 inches.
- (2) Total Depth 163 feet.
- (3) Water Level 79 feet below top of ground.
- (4) Cased to 15-8, Size 2
- (5) Screen: Size 2, Length 5'
- (6) Were any formations sealed against pollution?
_____ yes, _____ no.

If YES depth of formation _____

Why _____

Drillers Remarks: _____

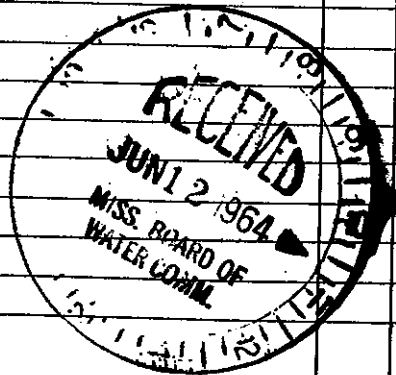

Well No.

(Use Back Side)

Mail this copy to Board of Water Commissioners 429 Miss. St. Jackson, Miss.