

HOLMES MISSISSIPPI BOARD OF WATER COMMISSIONERS

T 41
9-64

WATER WELL DRILLERS CODED

Date: Sept, 1964, Driller: Jack Martin County Holmes

(Name)

(1) Owner of Land: Roy Buchanan
(Name)
Durant
(Address)

(2) Location: NE 1/4, SE 1/4, Sec. 4 T14R4E
2 miles NW of Durant
(distance) (direction) (Nearest Town)

(3) Topography: Hilly
(Hilly) (Flat) (Level)

(4) Purpose of Well: Domestic
(Domestic Irrigation
Municipal, Industrial, Other)

Description & Color of Materials Sand, Clay, Red Clay, Shell, etc.	Thick- ness Feet	Depth Feet
<u>clay</u>	<u>16</u>	<u>16</u>

<u>Pipe clay, Sand</u>	<u>22</u>	<u>38</u>
<u>Sand</u>	<u>30</u>	<u>68</u>

CODED


Information upon completion of well:

- (1) Diameter 2 inches.
- (2) Total Depth 68 feet.
- (3) Water Level 32 feet below top of ground.
- (4) Cased to 63, Size 2
- (5) Screen: Size 2, Length 5'
- (6) Were any formations sealed against pollution?
yes, no.

If YES depth of formation _____

Why _____

Drillers Remarks: _____

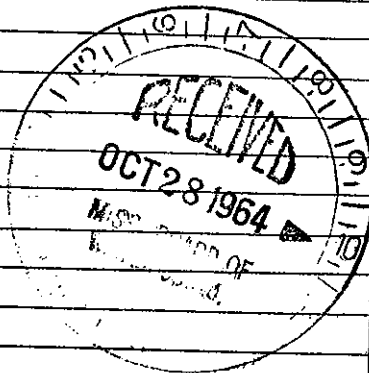

(Use Back Side)

Well No. _____

Mail this copy to Board of Water Commissioners 429 Miss. St. Jackson, Miss