

HOLMES MISSISSIPPI BOARD OF WATER COMMISSIONERS

T 42  
1-66

WATER WELL DRILLERS LOG

Date: Jan, 1966, Driller: Jack Martin <sup>CODED</sup> County Holmes  
(Name)

(1) Owner of Land: <u>Brooks Kimbrough</u> (Name)	Description & Color of Materials Sand, Clay, Red Clay, Shell, etc.	Thick- ness Feet	Depth Feet
<u>Durant</u> (Address)	<u>clay</u>	<u>11</u>	<u>11</u>
(2) Location: <u>SE 1/4, SW 1/4, Sec. 5 T4R4E</u> <u>3</u> miles <u>W</u> , of <u>Durant</u> (distance) (direction) (Nearest Town)	<u>red sand</u> <u>6" rock</u>	<u>33</u>	<u>44</u>
(3) Topography: (Hilly) (Flat) (Level)	<u>Mud. - little sand</u>	<u>92</u>	<u>136</u>
(4) Purpose of Well: <u>Domestic</u> (Domestic Irrigation Municipal, Industrial, Other)	<u>sands</u> <u>CODED</u>	<u>21</u>	<u>157</u>


Information upon completion of well:

- (1) Diameter 2 inches.
- (2) Total Depth 157 feet.
- (3) Water Level 125 feet below top of ground.
- (4) Cased to 152, Size 2
- (5) Screen: Size 2, Length 5
- (6) Were any formations sealed against pollution?  
\_\_\_\_\_ yes, \_\_\_\_\_ no.

If YES depth of formation \_\_\_\_\_

Why \_\_\_\_\_

Drillers Remarks: \_\_\_\_\_

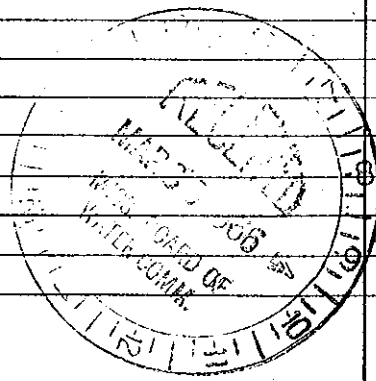

(Use Back Side)

Well No.

Mail this copy to Board of Water Commissioners 429 Miss. St. Jackson, Miss