


**HOLMES**  
 86-234 KSE-03  
 T 48

MISSISSIPPI DEPARTMENT OF NATURAL RESOURCES  
 Bureau of Land and Water Resources  
 Southport Mall  
 P.O. Box 10631  
 Jackson, Mississippi 39209  
**WATER WELL DRILLERS LOG** **CODED**

August 28, 1986 Dyer Well, Inc. Holmes  
 date well completed firm name county well located

LANDOWNER: <u>Billy Ellis</u>	description of formations encountered	from	to
<u>C/o Holmes County Bank</u>			
<u>Lexington, Miss. 39095</u> (mailing address)	<u>Clay</u>	<u>0</u>	<u>15</u>
	<u>Sand</u>	<u>16</u>	<u>21</u>
	<u>Medium Clay</u>	<u>22</u>	<u>195</u>
	<u>HARD SHALE BASE CLAY</u>	<u>196</u>	<u>339</u>
	<u>WHITE SAND (MED GRAV)</u>	<u>340</u>	<u>354</u>
	<u>Clay</u>	<u>355</u>	<u>361</u>
<b>WELL LOCATION:</b> sec. <u>7</u> T. <u>14</u> N. R. <u>4</u> E. <u>9</u> NW <u>9</u> miles <u>EAST</u> of <u>Lexington</u> (distance) (direction) (nearest town)			
<b>WELL PURPOSE:</b> <u>IRRIGATION</u> (home, irrigation, municipal, industrial)			
<b>WELL COMPLETION DATA:</b> (1) diameter (inches) <u>10 3/4</u> (2) total depth (feet) <u>354</u> (3) static water level (feet) <u>104</u> below top of ground. (4) casing <u>Steel</u> , <u>340</u> (material) (depth) <u>10 3/4</u> If telescope see back. (size) (5) screen <u>20</u> , <u>340</u> (length) (depth to top) <u>10 3/4</u> , <u>Mild Steel</u> (size) (material) (6) pump <u>10</u> , <u>150</u> (HP) (yield gpm) <u>Electric</u> (type power) (7) electric log <u>No</u> (yes or no) (organization running log) (8) how well bottom plugged <u>PLATE</u>			
<b>DRILLERS REMARKS:</b> <u># 86-234 KSE-03</u>			

CODED

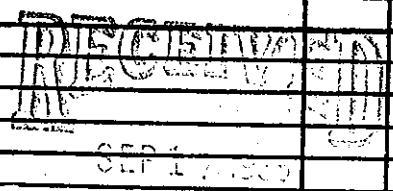

Department of Natural Resources  
 Bureau of Land & Water Resources