

MS-6W-2688

Coded

MISSISSIPPI  
 BOARD OF WATER COMMISSIONERS  
 416 North State Street  
 Jackson, Mississippi 39201

WATER WELL DRILLERS LOG

Holmes  
 U1  
 1/67  
 ELEC LOG

1-10-67

date well completed

Robert Balleff Co

firm name

Helman Co

county well located

LANDOWNER: Holland Creek Water Co

Lexington Miss

(mailing address)

WELL LOCATION:

sec. 1 T. 13 N. R. 1 E. S. W.

(distance) miles (direction) of (nearest town)

WELL PURPOSE:

(home, irrigation, municipal, industrial)

WELL COMPLETION DATA:

- (1) diameter (inches) 6" x 3"
- (2) total depth (feet) 1310
- (3) static water level (feet) 142 below above top of ground.
- (4) casing Black (material) 1270 (depth) 6" x 3" (size) if telescope see back.
- (5) screen 40' (length) 1270 (depth to top) 1230' (size) SS (material)
- (6) pump 15 (HP) 145 gpm (yield gpm) Electric (type power)
- (7) electric log yes (yes or no) PLS 95 (organization running log)
- (8) how well bottom plugged Back Washer Valve


description of formations encountered

from

to

Dirt	0	30
sand + clay	30	110
Sand	110	230
Shale	230	300
Sand	300	425
Shale + Sand	425	580
Shale	580	1050
Green Sand	1050	1180
shale	1180	1270
Sand + Shale	1175	1310
Sand	1210	1325
Shale	1325	1450

If the info on back is right the screens are split from 1230' - 1250' + 1290' - 1310'. Casing then couldn't go to 1370'

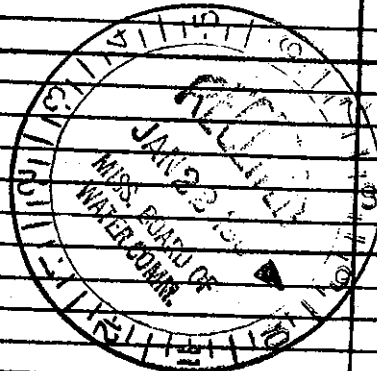

DRILLERS REMARKS: