

HOLMES

MISSISSIPPI BOARD OF WATER COMMISSIONERS

U6
7-62

WATER WELL DRILLERS LOG

CODED

Date: July, 1962, Driller: Jack Martin County Holmes
(Name)

(1) Owner of Land: <u>Virian Farrell</u> (Name)	Description & Color of Materials Sand, Clay, Red Clay, Shell, etc.	Thick- ness Feet	Depth Feet
<u>Lexington</u> (Address)	Top Clay	12	12
SW 1/4, <u>DB93-P137</u> 1/4, Sec. 13 T3R1E	Clay - little sand	14	26
4 miles <u>West</u> , of <u>Shenandoah</u> (distance) (direction) (Nearest Town)	Pipe clay Mud	10	36
(3) Topography: <u>Hilly</u> (Hilly) (Flat) (Level)	Fine sand - mud	9	130
(4) Purpose of Well: <u>Domestic</u> (Domestic Irrigation Municipal, Industrial, Other)	Mud Sand	56	186
	CODED	47	233
		47	280


Information upon completion of well:

- (1) Diameter 2 inches.
- (2) Total Depth 276 feet.
- (3) Water Level 85 feet below top of ground.
- (4) Cased to 266, Size 2
- (5) Screen: Size 2", Length 10'
- (6) Were any formations sealed against pollution?
_____ yes, _____ no.

If YES depth of formation _____

Why _____

Drillers Remarks: _____

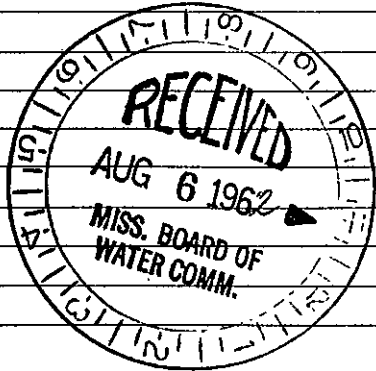

(Use Back Side)

Well No.