

HOLMES MISSISSIPPI BOARD OF WATER COMMISSIONERS

U7  
6-66

WATER WELL DRILLERS LOG

CODED

Date: June, 1966, Driller: Jack Martin County Holmes

(Name)

(1) Owner of Land: Henry Roberts  
(Name)  
Seymour  
(Address)

(2) Location: NW 1/4, NW 1/4, Sec. 12, T. 31 N, R. 12 E  
11 miles SW, of Seymour  
(distance) (direction) (Nearest Town)

(3) Topography: Hilly  
(Hilly) (Flat) (Level)

(4) Purpose of Well: Domestic  
(Domestic Irrigation  
Municipal, Industrial, Other)

Description & Color of Materials Sand, Clay, Red Clay, Shell, etc.	Thick- ness Feet	Depth Feet
<u>Clay</u>	<u>27</u>	<u>27</u>
<u>Clay</u>	<u>11</u>	<u>38</u>
<u>S. Clay - Sand</u>	<u>18</u>	<u>56</u>
<u>Sand</u>	<u>10</u>	<u>66</u>
<u>Mud</u>	<u>36</u>	<u>102</u>
<u>Sand - Mud</u>	<u>11</u>	<u>113</u>
<u>Mud</u>	<u>110</u>	<u>223</u>
<u>Sand</u>	<u>83</u>	<u>306</u>

Information upon completion of well:

(1) Diameter 2 inches.

(2) Total Depth 306 feet.

(3) Water Level 92 feet below top of ground.

(4) Cased to 296, Size 2.


(5) Screen: Size 2, Length 10'.

(6) Were any formations sealed against pollution?  
\_\_\_\_\_ yes, \_\_\_\_\_ no.

If YES depth of formation \_\_\_\_\_

Why \_\_\_\_\_

Drillers Remarks: \_\_\_\_\_

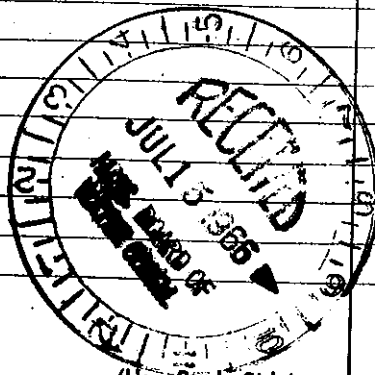

(Use Back Side)

Well No.

Mail this copy to Board of Water Commissioners 429 Miss. St. Jackson, Miss.