

Holmes
 U8
 11-66

MISSISSIPPI BOARD OF WATER COMMISSIONERS
CODED

WATER WELL DRILLERS LOG

Date: Nov 2, 1966, Driller: Jack Martin County Holmes
 (When well drilled) (Name) (Where well is located)

(1) Owner of Land: <u>Lester Edwards</u> (Name)	Description & Color of Materials Sand, Clay, Red Clay, Shell, etc.	Thick- ness Feet	Depth Feet
<u>Lexington Rt 4</u> (Address)	<u>Clay</u>	<u>24</u>	<u>24</u>
(2) Location: <u>SE 1/4, SE 1/4, Sec. 8 T3R1E,</u>	<u>Gravel + Sand</u>	<u>34</u>	<u>58</u>
<u>8</u> miles <u>W.</u> of <u>Echenoz</u> (distance) (direction) (Nearest Town)	<u>Sand</u>	<u>7</u>	<u>65</u>
(3) Topography: <u>Hilly</u> (Hilly) (Flat) (Level)	<u>Mud</u>	<u>143</u>	<u>208</u>
(4) Purpose of Well: <u>Home</u> (Domestic Irrigation Municipal, Industrial, Other)	<u>Mud - Sand streaks</u>	<u>102</u>	<u>310</u>
	CODED <u>Mud</u>	<u>52</u>	<u>362</u>

Information upon completion of well:

- (1) Diameter 2 inches.
- (2) Total Depth 378 feet.
- (3) Water Level 131 feet below top of ground.
- (4) Cased to 368, Size 2
- (5) Screen: Size 2, Length 10
- (6) Were any formations sealed against pollution?
 yes, no.

If YES depth of formation _____


Why _____

Drillers Remarks: I did not install pump

Yield in gpm: 15.9 PM (air compressor)

Size pump: _____

Type power: _____

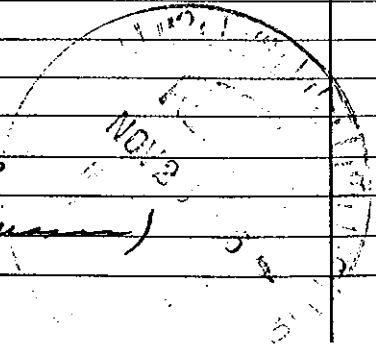

Mail this copy to Board of Water Commissioners 429 Miss. St. Jackson, Miss.