

V5
5-62

WATER WELL DRILLERS LOG

CODED

Date: May, 1962, Driller: Jack Martin County Holmes
(Name)

(1) Owner of Land:	Description & Color of Materials Sand, Clay, Red Clay, Shell, etc.	Thick- ness Feet	Depth Feet
<u>Ebeneyzer McEachern</u> (Name) <u>Ebeneyzer Miss</u> (Address)	<u>TOP clay</u>	<u>21</u>	<u>21</u>
(2) Location: <u>1/4, 1/4, Sec. 16 T13 R25</u>	<u>Clay-Sand streaks</u>	<u>44</u>	<u>65</u>
<u>In Ebeneyzer</u> (distance) miles (direction) of (Nearest Town)	<u>Sand</u>	<u>23</u>	<u>88</u>
(3) Topography: <u>Hilly</u> (Hilly) (Flat) (Level)			
(4) Purpose of Well: <u>Domestic</u> (Domestic Irrigation Municipal, Industrial, Other)			

Information upon completion of well:


- (1) Diameter 2 inches.
- (2) Total Depth 88 feet.
- (3) Water Level 60 feet below top of ground.
- (4) Cased to 83, Size 2
- (5) Screen: Size 2", Length 5'
- (6) Were any formations sealed against pollution?
_____ yes, _____ no.

If YES depth of formation _____

Why _____

Drillers Remarks: _____

CODED

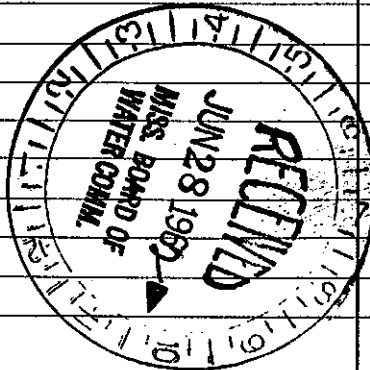

Well No.

(Use Back Side)