

HOLMES MISSISSIPPI BOARD OF WATER COMMISSIONERS

V9

WATER WELL DRILLERS CODED

~~7-200~~

1-20-61

Date: 1-20, 1961, Driller: Jack Martin, County: Holmes

(Name)

(1) Owner of Land:	Description & Color of Materials Sand, Clay, Red Clay, Shell, etc.	Thick- ness Feet	Depth Feet
W. E. Drennon (Name)	Red clay	18	12
Pickens (Address)	Pipe clay	21	39
(2) Location: NE 1/4, NE 1/4, Sec. 27 T13R2E	Sand	8	47
2 miles South of Ebenezer (distance) (direction) (Nearest Town)	Mud-Sand Stracks	25	72
(3) Topography: Hilly (Hilly) (Flat) (Level)	Sand	18	90
(4) Purpose of Well: Domestic (Domestic Irrigation Municipal, Industrial, Other)	CODED		


Information upon completion of well:

- (1) Diameter 2 inches.
- (2) Total Depth 80 feet.
- (3) Water Level 49 feet below top of ground.
- (4) Cased to 75, Size 2
- (5) Screen: Size 2, Length 5ft.
- (6) Were any formations sealed against pollution?
 yes, no.

If YES depth of formation _____

Why _____

Drillers Remarks: _____

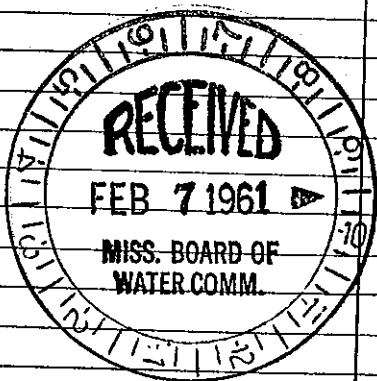

Well No.

(Use Back Side)

Mail this copy to Board of Water Commissioners 429 Miss. St. Jackson, Miss