

HOLMES MISSISSIPPI BOARD OF WATER COMMISSIONERS

V12  
1-63

WATER WELL DRILLERS LOG

CODED

Date: Jan, 1963, Driller: Jack Marsh County Holmes

(Name)

		Description & Color of Materials Sand, Clay, Red Clay, Shell, etc.	Thick- ness Feet	Depth Feet
(1) Owner of Land:	<u>T.E. Hefphey</u> (Name) <u>Ebenezer</u> (Address)	<u>Top clay</u>	<u>18</u>	<u>18</u>
(2) Location:	<u>NE 1/4, SE 1/4, Sec. 15 T13R2E</u> <u>1/2</u> miles <u>East</u> , of <u>Ebenezer</u> (distance) (direction) (Nearest Town)	<u>Pipe clay</u>	<u>12</u>	<u>30</u>
(3) Topography:	<u>Hilly</u> (Hilly) (Flat) (Level)	<u>Pipe Clay &amp; Sand</u>	<u>18</u>	<u>48</u>
(4) Purpose of Well:	<u>Domestic</u> (Domestic Irrigation Municipal, Industrial, Other)	<u>Sand</u>	<u>41</u>	<u>89</u>


Information upon completion of well:

- (1) Diameter 2 inches.
- (2) Total Depth 89 feet.
- (3) Water Level 46 feet below top of ground.
- (4) Cased to 84, Size 2
- (5) Screen: Size 2", Length 5'
- (6) Were any formations sealed against pollution?  
\_\_\_\_\_ yes, \_\_\_\_\_ no.

If YES depth of formation \_\_\_\_\_

Why \_\_\_\_\_

Drillers Remarks: \_\_\_\_\_

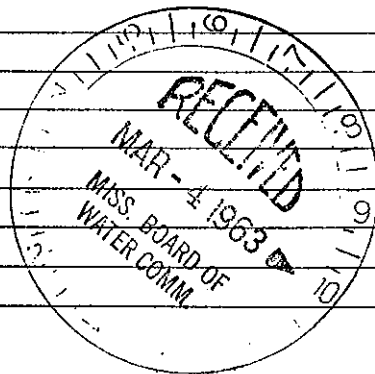

(Use Back Side)

Well No.

Mail this copy to Board of Water Commissioners 429 Miss. St. Jackson, Miss.