

HOLMES
V13
6-63

MISSISSIPPI BOARD OF WATER COMMISSIONERS

CODED
WATER WELL DRILLERS LOG

Date: June, 1963, Driller: Jack Martin County Holmes
(Name)

(1) Owner of Land:	Description & Color of Materials Sand, Clay, Red Clay, Shell, etc.	Thick- ness Feet	Depth Feet
<u>Humphrey's</u> (Name)	<u>Clay</u>	<u>12</u>	<u>12</u>
<u>Ehenezer</u> (Address)	<u>Pipe Clay</u>	<u>12</u>	<u>24</u>
(2) Location: <u>NE 1/4, SE 1/4, Sec. 16 T13 R28</u> <u>in Ehenezer</u> (distance) (direction) (Nearest Town)	<u>Sand</u>	<u>12</u>	<u>36</u>
(3) Topography: <u>Hilly</u> (Hilly) (Flat) (Level)	<u>Pipe Clay</u>	<u>8</u>	<u>44</u>
(4) Purpose of Well: <u>Domestic</u> (Domestic Irrigation Municipal, Industrial, Other)	<u>Sand</u>	<u>90</u>	<u>134</u>

CODED


Information upon completion of well:

- (1) Diameter 4 inches.
- (2) Total Depth 134 feet.
- (3) Water Level 77 feet below top of ground.
- (4) Cased to 120, Size 4.
- (5) Screen: Size 4, Length 14.
- (6) Were any formations sealed against pollution?
_____ yes, _____ no.

If YES depth of formation _____

Why _____

Drillers Remarks: _____

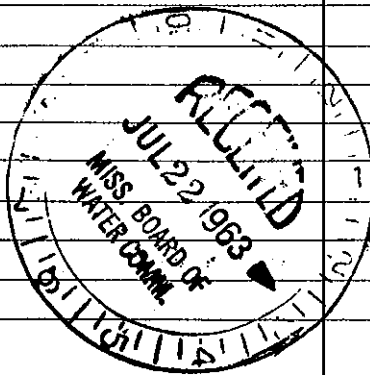

(Use Back Side)

Well No.

Mail this copy to Board of Water Commissioners 429 Miss. St. Jackson, Miss.