

HOLMES

V 14
Date: Sept 9-63

WATER WELL DRILLERS LOG

CODED

Date: Sept 9-63, Driller: Jack Martin County Holmes (Name)

(1) Owner of Land: <u>Guy Bradley</u> (Name)	Description & Color of Materials Sand, Clay, Red Clay, Shell, etc.	Thick- ness Feet	Depth Feet
<u>Lexington</u> (Address)	Clay	24	24
(2) Location: <u>NW 1/4, NE 1/4, Sec. 23 T13R2E</u>	Pipe clay + sand	8	32
<u>2</u> miles <u>East</u> , of <u>Ebenezer</u> (distance) (direction) (Nearest Town)	Sand	36	68
(3) Topography: <u>Hilly</u> (Hilly) (Flat) (Level)			
(4) Purpose of Well: <u>Domestic</u> (Domestic Irrigation Municipal, Industrial, Other)			

CODED


Information upon completion of well:

- (1) Diameter 2 inches.
- (2) Total Depth 68 feet.
- (3) Water Level 26 feet below top of ground.
- (4) Cased to 63, Size 2
- (5) Screen: Size 2", Length 5'
- (6) Were any formations sealed against pollution?
_____ yes, _____ no.

If YES depth of formation _____

Why _____

Drillers Remarks: _____

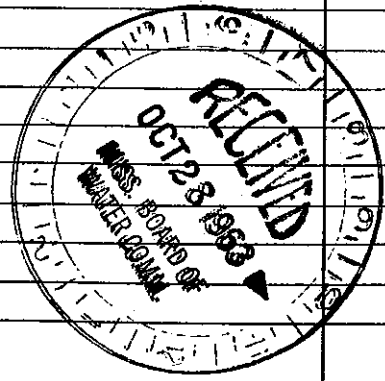

Well No.

(Use Back Side)

Mail this copy to Board of Water Commissioners 429 Miss. St. Jackson, Miss.