

HOLMES MISSISSIPPI BOARD OF WATER COMMISSIONERS

V16
2-64

WATER WELL DRILLERS LOG

CODED

Date: Feb, 1964, Driller: Jack Martin County Holmes
(Name)

(1) Owner of Land: H.O. Edwards
(Name)

Lexington
(Address)

(2) Location: 1/4 NW 1/4, Sec. 24 T13 R22

2 miles East of Shipyard
(distance) (direction) (Nearest Town)

(3) Topography: Hilly
(Hilly) (Flat) (Level)

(4) Purpose of Well: Domestic
(Domestic Irrigation
Municipal, Industrial, Other)

Description & Color of Materials
Sand, Clay, Red Clay, Shell, etc.

Thick-
ness
Feet

Depth
Feet

Clay

28

28

Sand

14

42

Sand - pipe clay streak

72

114

Sand

17

131

CODED

Information upon completion of well:

(1) Diameter 2 inches.

(2) Total Depth 131 feet.

(3) Water Level 28 feet below top of ground.

(4) Cased to 126, Size 2

(5) Screen: Size 2", Length 5'


(6) Were any formations sealed against pollution?

yes, no.

If YES depth of formation

Why

Drillers Remarks:

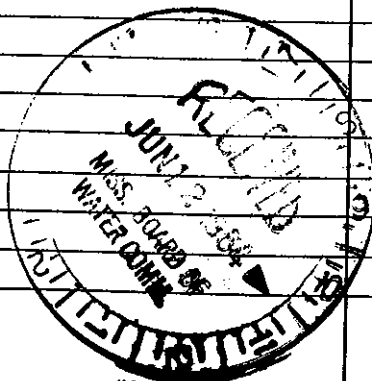

(Use Back Side)

Well No.

Mail this copy to Board of Water Commissioners 429 Miss. St. Jackson, Miss.