

HOLMS
W1
7-6-65

MISSISSIPPI BOARD OF WATER COMMISSIONERS

WATER WELL DRILLERS LOG

CODED

Date: July 6, 1965, Driller: McKay County Holmes

(Name)

(1) Owner of Land: Fred McKay
(Name)

Purdum Miss
(Address)

(2) Location: 2 12 BE
1/4, 1/4, Sec. T. R.

5 miles NS of Robin
(distance) (direction) (Nearest Town)

(3) Topography: (Hilly) (Flat) (Level)

(4) Purpose of Well: Home
(Domestic Irrigation, Municipal, Industrial, Other)

Description & Color of Materials Sand, Clay, Red Clay, Shell, etc.	Thick- ness Feet	Depth Feet
<u>Red Clay</u>	<u>0</u>	<u>20</u>
<u>Red Sand</u>	<u>20</u>	<u>40</u>
<u>Red Sand</u>	<u>40</u>	<u>44</u>
<u>White Sand</u>	<u>46</u>	<u>90</u>
<u>Blue Clay</u>	<u>90</u>	<u>140</u>
<u>Sandy Shell</u>	<u>140</u>	<u>240</u>
<u>Brown Shell</u>	<u>240</u>	<u>300</u>
<u>Fine Sand</u>	<u>300</u>	<u>340</u>
<u>Med Sand</u>	<u>340</u>	<u>380</u>

Information upon completion of well:

(1) Diameter 2 1/2 inches 210 ft

(2) Total Depth 380 feet.

(3) Water Level 66 feet below top of ground.

(4) Cased to _____, Size _____

(5) Screen: Size 007, Length 20


(6) Were any formations sealed against pollution?
_____ yes, no.

If YES depth of formation _____

Why _____

Drillers Remarks: _____

CODED

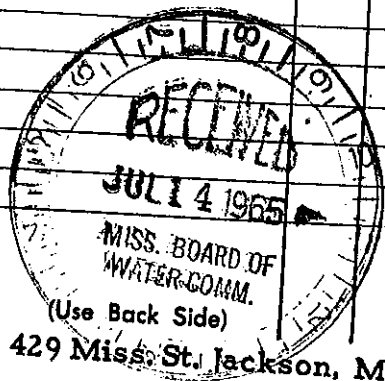

Well No. _____

Mail this copy to Board of Water Commissioners 429 Miss. St. Jackson, Miss.