

HOLMES MISSISSIPPI BOARD OF WATER COMMISSIONERS

W5

1-6-65

WATER WELL DRILLERS LOG

CODED

Date: 1/6/, 1965, Driller: McKary County Holmes
(Name)

(1) Owner of Land: C Wentworth
(Name)
Pickens Miss
(Address)

(2) Location: 3/4, 1/4, Sec. 70 T12R3E
2 miles N of Pickens
(distance) (direction) (Nearest Town)

(3) Topography: (Hilly) (Flat) (Level)


(4) Purpose of Well: Home
(Domestic Irrigation, Municipal, Industrial, Other)

Description & Color of Materials Sand, Clay, Red Clay, Shell, etc.	Thick- ness Feet	Depth Feet
<u>Red clay</u>	<u>0</u>	<u>20</u>
<u>Red clay</u>	<u>20</u>	<u>40</u>
<u>Blue clay</u>	<u>40</u>	<u>60</u>
<u>Red clay</u>	<u>60</u>	<u>120</u>
<u>Shale</u>	<u>120</u>	<u>180</u>
<u>Sand</u>	<u>180</u>	<u>200</u>
<u>Shale</u>	<u>200</u>	<u>240</u>
<u>Brown shale</u>	<u>240</u>	<u>300</u>
<u>Sandy shale</u>	<u>300</u>	<u>320</u>
<u>Fine sand</u>	<u>320</u>	<u>360</u>
<u>Fine to med sand</u>	<u>360</u>	<u>400</u>

Information upon completion of well:

- (1) Diameter 2 inches.
- (2) Total Depth 400 feet.
- (3) Water Level 60 feet below top of ground.
- (4) Cased to —, Size —.
- (5) Screen: Size 007, Length 20.
- (6) Were any formations sealed against pollution?
— yes, no.

Rad Pump **CODED**

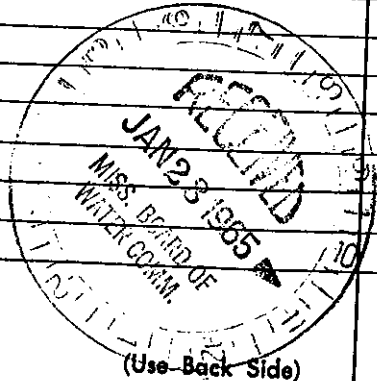

Well No.

Mail this copy to Board of Water Commissioners 429 Miss. St. Jackson, Miss.