

ELOG #40

Holmes  
W 10  
9-66  
Ejec. Log  
Sept 1966

MISSISSIPPI  
BOARD OF WATER COMMISSIONERS  
416 North State Street  
Jackson, Mississippi 39201

CODED

WATER WELL DRILLERS LOG

Robert E. Kattallo  
Holmes

LANDOWNER: Holmes County

Beard Education  
Holmes County, Miss.  
(mailing address)

description of formations encountered

from to

WELL LOCATION:


sec 36 T 13 N R 3 E  
3 miles SW of Goodman  
(distance) (direction) (nearest town)

WELL PURPOSE: Municipal  
(home, irrigation, municipal, industrial)

WELL COMPLETION DATA:

- (1) diameter (inches) 4x2 1/2
- (2) total depth (feet) 1585
- (3) static water level (feet) flow below top of ground.
- (4) casing St. 1545  
(material) (depth)  
4x2 1/2 if telescope see back.  
(size)
- (5) screen 40' 1545  
(length) (depth to top)  
. D 12 S.S.  
(size) (material)
- (6) pump 3 60 flow  
(HP) (yield gpm)  
turbine  
(type power)
- (7) electric log Yes  
(yes or no)  
M. G. S.  
(organization running log)
- (8) how well bottom plugged B.P.V.

Top Soil	0	25
Yellow Sand	25	30
Yellow Clay	30	50
Fine Sand	50	65
Clay	65	75
Sand	75	100
Gumbo	100	115
Sand	115	120
Shale	120	145
Sand	145	150
Sand - Shale	150	255
Coarse white sand	255	360
Sandy Shale	360	440
White Coarse sand	440	520
Shale	520	640
Rock	640	645
Shale w/ sand streaks	645	800
Green Sand	800	815
Shale + Gumbo	815	1008
Fine white sand w/ micro	1008	1085
Shale streaks	1085	1115
Sand	1115	1125
Gumbo	1125	1130
Sand & Shale	1130	1180
Hard Shale	1180	1466
Sand	1466	1491
Hard Shale	1491	1520
Sand	1520	1585

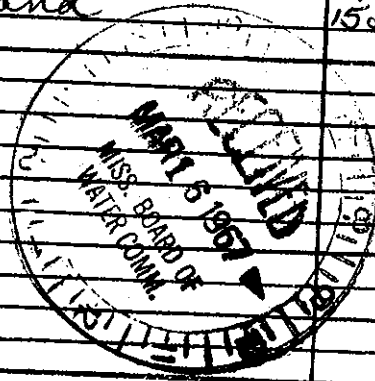

DRILLERS REMARKS: