

HOLMES
W 25
4-62

MISSISSIPPI BOARD OF WATER COMMISSIONERS

CODED

WATER WELL DRILLERS LOG

Date: April, 1962, Driller: Jack Monte Walms
(Name)

| (1) Owner of Land: | Description & Color of Materials Sand, Clay, Red Clay, Shell, etc. | Thick- ness Feet | Depth Feet |
|---|---|------------------------|---------------|
| <u>John Malon</u> (Name) | Top clay | 16 | 16 |
| <u>Pickens Miss</u> (Address) | Pipe clay | 26 | 42 |
| (2) Location: <u>SW 1/4, NW 1/4, Sec. 5 T12R3E</u> | Pipe clay sand | 3 | 45 |
| <u>5</u> miles <u>NW</u> , of <u>Pickens</u> (distance) (direction) (Nearest Town) | Black mud | 45 | 90 |
| (3) Topography: <u>Hilly</u> (Hilly) (Flat) (Level) | Fine sand | 2 | 92 |
| (4) Purpose of Well: <u>Domestic</u> (Domestic Irrigation Municipal, Industrial, Other) | Black mud | 47 | 145 |
| | <u>Sand</u> | 40 | 185 |

CODED


Information upon completion of well:

- (1) Diameter 2 inches.
- (2) Total Depth 185 feet.
- (3) Water Level 92 feet below top of ground.
- (4) Cased to 180, Size 2.
- (5) Screen: Size 2", Length 5 ft.
- (6) Were any formations sealed against pollution?
_____ yes, _____ no.

If YES depth of formation _____

Why _____

Drillers Remarks: _____

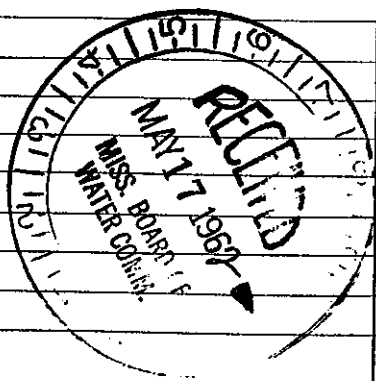

Well No.

(Use Back Side)