

HOLMES MISSISSIPPI BOARD OF WATER COMMISSIONERS

W 26
7-64

WATER WELL DRILLERS LOG CODED

Date: July, 19 64, Driller: Jack Martin County Holmes
(Name)

(1) Owner of Land:	Description & Color of Materials Sand, Clay, Red Clay, Shell, etc.	Thick- ness Feet	Depth Feet
S. A. Floyd (Name) Goodman (Address)	Clay	16	16
(2) Location: SW 1/4, NE 1/4, Sec. 1 T.13R3E	Pipe Clay - Sand	41	57
3 miles NW of Goodman (distance) (direction) (Nearest Town)	Sand	23	80
(3) Topography: Hilly (Hilly) (Flat) (Level)			
(4) Purpose of Well: Domestic (Domestic Irrigation Municipal, Industrial, Other)			

CODED


Information upon completion of well:

- (1) Diameter _____ inches.
- (2) Total Depth 80 feet.
- (3) Water Level 55 feet below top of ground.
- (4) Cased to 72, Size 2
- (5) Screen: Size 2, Length 5
- (6) Were any formations sealed against pollution?
_____ yes, _____ no.

If YES depth of formation _____

Why _____

Drillers Remarks: _____

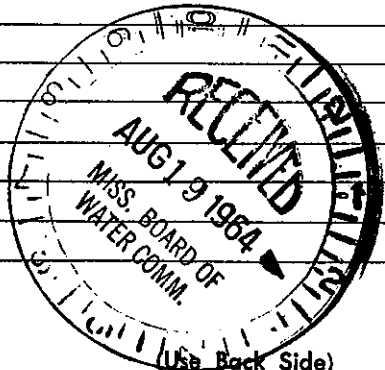

Well No.

Mail this copy to Board of Water Commissioners 429 Miss. St. Jackson, Miss