

HOLMES
W28
1-66

MISSISSIPPI BOARD OF WATER COMMISSIONERS
WATER WELL DRILLERS LOG

CODED

Date: Jan, 1966, Driller: Jack Martin County Holmes
(Name)

(1) Owner of Land: M.D. Lawrence
(Name)
Pickens
(Address)
(2) Location: SW 1/4, NE 1/4, Sec. 14, T13R2E
3 miles N of Pickens
(distance) (direction) (Nearest Town)
(3) Topography: Hilly
(Hilly) (Flat) (Level)
(4) Purpose of Well: Domestic
(Domestic Irrigation
Municipal, Industrial, Other)


Description & Color of Materials Sand, Clay, Red Clay, Shell, etc.	Thick- ness Feet	Depth Feet
<u>Clay</u>	<u>10</u>	<u>10</u>
<u>P. & S. Sand</u>	<u>30</u>	<u>40</u>
<u>Sand</u>	<u>49</u>	<u>89</u>

CODED

Information upon completion of well:

(1) Diameter 2 inches.
(2) Total Depth 89 feet.
(3) Water Level 38 feet below top of ground.
(4) Cased to 84, Size 2
(5) Screen: Size 2, Length 5
(6) Were any formations sealed against pollution?
_____ yes, _____ no.

If YES depth of formation _____
Why _____
Drillers Remarks: _____

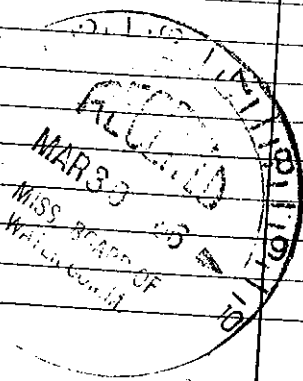

(Use Back Side)

Well No.