

HOLMES MISSISSIPPI BOARD OF WATER COMMISSIONERS

W32

6-66

WATER WELL DRILLERS LOG

Date: June, 19 66, Driller: Jack RODED County Holmes  
(Name)

(1) Owner of Land:	Description & Color of Materials Sand, Clay, Red Clay, Shell, etc.	Thick- ness Feet	Depth Feet
<u>Kirk Thurman</u> <small>(Name)</small>			
<u>Picheno</u> <small>(Address)</small>	<u>clay</u>	<u>14</u>	<u>14</u>
(2) Location: <u>NE 1/4, NW 1/4, Sec. 19 T13R32E</u>	<u>pipe clay</u>	<u>12</u>	<u>26</u>
<u>3</u> miles <u>SE</u> of <u>Edwards</u> <small>(distance) (direction) (Nearest Town)</small>	<u>pipe clay &amp; sand</u>	<u>35</u>	<u>61</u>
(3) Topography: <u>Hilly</u> <small>(Hilly) (Flat) (Level)</small>	<u>Sand</u>	<u>70</u>	<u>131</u>
(4) Purpose of Well: <u>Domestic</u> <small>(Domestic Irrigation Municipal, Industrial, Other)</small>	<b>CODED</b>		


Information upon completion of well:

- (1) Diameter 2 inches.
- (2) Total Depth 131 feet.
- (3) Water Level 21 feet below top of ground.
- (4) Cased to 126, Size 2
- (5) Screen: Size 2, Length 5'
- (6) Were any formations sealed against pollution?  
 yes,  no.

If YES depth of formation \_\_\_\_\_

Why \_\_\_\_\_

Drillers Remarks: \_\_\_\_\_

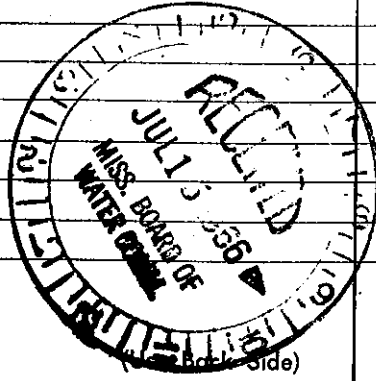

Well No. \_\_\_\_\_