

HOLMES
W 33
7-66

MISSISSIPPI BOARD OF WATER COMMISSIONERS

WATER WELL DRILLERS LOG CODED

Date: July, 1966, Driller: Jack Martin County Holmes
(Name)

(1) Owner of Land: Luther Upshaw
(Name)
Pickens Rt #1
(Address)

(2) Location: NE 1/4, SE 1/4, Sec. 21 T13R3E
5 miles N, of Pickens
(distance) (direction) (Nearest Town)

(3) Topography: Hilly
(Hilly) (Flat) (Level)

(4) Purpose of Well: Domestic
(Domestic Irrigation
Municipal, Industrial, Other)

Description & Color of Materials Sand, Clay, Red Clay, Shell, etc.	Thick- ness Feet	Depth Feet
Clay	16	16
Pipe Clay	5	21
Mud	2.5	46
Sand & Mud	2.5	71
Sand	6	77
Mud	14	91
Sand	5	96
Mud & Sand CODED	14	110
Fine Sand	32	142
Mud	33	175
Sand	23	198

Information upon completion of well:

(1) Diameter 2 inches.

(2) Total Depth 198 feet.

(3) Water Level 42 feet below top of ground.

(4) Cased to 189, Size 2


(5) Screen: Size 2, Length 9

(6) Were any formations sealed against pollution?
_____ yes, no.

If YES depth of formation _____

Why _____

Drillers Remarks: _____

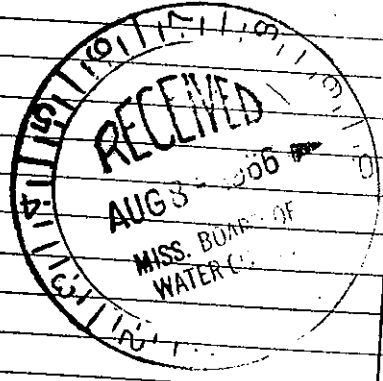

Well No.

(Use Back Side)