

Holmes
W 3A
8-66

MISSISSIPPI BOARD OF WATER COMMISSIONERS

CODED

WATER WELL DRILLERS LOG

Date: Aug, 1966, Driller: Jack Martin County Holmes
(Name)

(1) Owner of Land:	Description & Color of Materials Sand, Clay, Red Clay, Shell, etc.	Thick- ness Feet	Depth Feet
<u>John Killebrew</u> (Name) <u>Goodman, Miss</u> (Address)	<u>Clay</u>	<u>4</u>	<u>4</u>
(2) Location: <u>SW 1/4, NW 1/4, Sec. 2 T13R3E</u> <u>5</u> miles <u>NW</u> of <u>Goodman</u> (distance) (direction) (Nearest Town)	<u>Rocks</u>	<u>4</u>	<u>8</u>
(3) Topography: <u>Hilly</u> (Hilly) (Flat) (Level)	<u>Sand</u>	<u>8</u>	<u>16</u>
(4) Purpose of Well: <u>Domestic</u> (Domestic Irrigation Municipal, Industrial, Other)	<u>CODED Pipe clay</u>	<u>3</u>	<u>19</u>
	<u>Sand-pipe clay streaks</u>	<u>27</u>	<u>46</u>
	<u>Sand</u>	<u>94</u>	<u>140</u>

Information upon completion of well:

(1) Diameter 2 inches.

(2) Total Depth 140 feet.

(3) Water Level 103 feet below top of ground.

(4) Cased to 1.35, Size 2


(5) Screen: Size 2", Length 5'

(6) Were any formations sealed against pollution?
 yes, no.

If YES depth of formation _____

Why _____

Drillers Remarks: _____

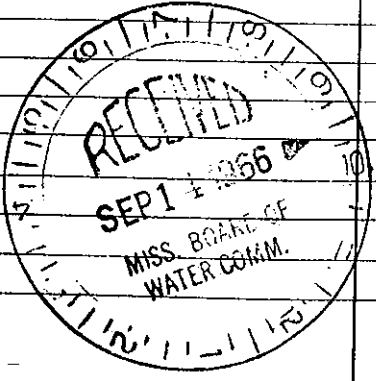

Well No.

(Use Back Side)

Mail this copy to Board of Water Commissioners 429 Miss. St. Jackson, Miss