

Holmes

W35
10-66

MISSISSIPPI BOARD OF WATER COMMISSIONERS

WATER WELL DRILLERS LOG

CODED

Date: Oct, 1966, Driller: Jack Martin County Holmes
(When well drilled) (Name) (Where well is located)

(1) Owner of Land: Luther Upton
(Name)
Pickens Route
(Address)
(2) Location: NW 1/4, SE 1/4, Sec. 5 T12R3E
3 miles NW of Pickens
(distance) (direction) (Nearest Town)
(3) Topography: Hilly
(Hilly) (Flat) (Level)
(4) Purpose of Well: Home
(Domestic Irrigation
Municipal, Industrial, Other)


Description & Color of Materials Sand, Clay, Red Clay, Shell, etc.	Thick- ness Feet	Depth Feet
Clay	13	13
Sand	12	25
P clay	11	36
Mud	38	74
Mud-Fine sand	16	90
Mud	34	124
Sand	7	131
Mud	41	172
Fine Sand	10	182
Mud	34	216
Fine Sand	5	221
Mud	49	270
Rock layers - Mud	10	280
Mud	74	354
Rock layers - Mud	40	394
Fine sand	21	415
Mud -	180	595
Sand	45	640

CODED

Information upon completion of well:

(1) Diameter 2 inches.
(2) Total Depth 640 feet.
(3) Water Level 110 feet below top of ground.
(4) Cased to 630, Size 2
(5) Screen: Size 2, Length 10
(6) Were any formations sealed against pollution?
_____ yes, no.

If YES depth of formation _____
Why _____
Drillers Remarks: _____
Yield in gpm: 10
Size pump: 2 H.P. Compressor
Type power: Electric

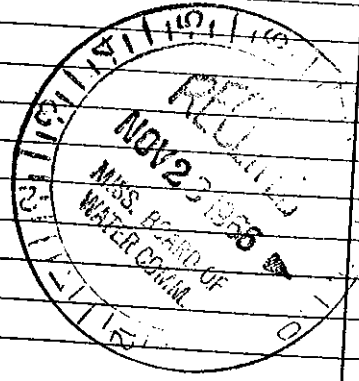

File this copy to Board of Water Commissioners 429 Miss. St. Jackson, Miss.