

HOLMES  
W 38  
3-68

MISSISSIPPI  
BOARD OF WATER COMMISSIONERS  
416 North State Street  
Jackson, Mississippi 39201

CODED

WATER WELL DRILLERS LOG

3-17-1968 date well completed  
Jack Martin firm name  
Holmes county well located

LANDOWNER:	description of formations encountered	from	to
Claudia Simmons			
Rt 1	Clay	0	36
Goodman Mine (mailing address)	Sand	36	62

WELL LOCATION:  
sec. 36 T. 13 N R. 3 E  
2 1/2 miles NE of Pichee  
(distance) (direction) (nearest town)

WELL PURPOSE: Home  
(home, irrigation, municipal, industrial)

CODED

WELL COMPLETION DATA:

(1) diameter (inches) 2

(2) total depth (feet) 62

(3) static water level (feet) 14 below top of ground.


(4) casing Steel, 57 (material), (depth)  
(size) if telescope see back.

(5) screen 5, 57 (length), (depth to top)  
2, Stainless Steel (size), (material)

(6) pump 1, 10 (HP), (yield gpm)  
Elec (type power)

(7) electric log No (yes or no)  
(organization running log)

(8) how well bottom plugged Cap

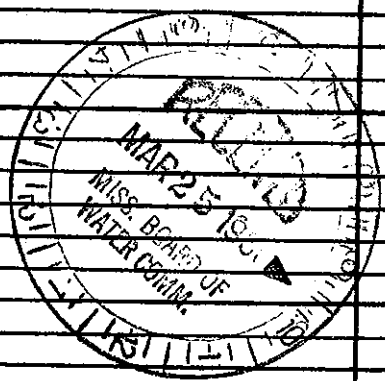

DRILLERS REMARKS: