

HOLMES
W 39
4-68

MISSISSIPPI
BOARD OF WATER COMMISSIONERS
416 North State Street
Jackson, Mississippi 39201

CODED

WATER WELL DRILLERS LOG

April 19 68 Jack Martin Holmes
date well completed firm name county well located

LANDOWNER: W. J. Waits
Goalman Miss
(mailing address)

WELL LOCATION:
sec. 21 T. 13 N R. 3 E
4 miles W of Goalman
(distance) (direction) (nearest town)


WELL PURPOSE: Home
(home, irrigation, municipal, industrial)

WELL COMPLETION DATA:

- (1) diameter (inches) 2
- (2) total depth (feet) 146
- (3) static water level (feet) 25 below top of ground.
- (4) casing Steel 142 (material) (depth)
2 (size) if telescope see back.
- (5) screen 4 142 (length) (depth to top)
2 (size) Stumblers Steel (material)
- (6) pump 1 9 (HP) (yield gpm)
Elex (type power)
- (7) electric log No (yes or no)
(organization running log)
- (8) how well bottom plugged Cap

description of formations encountered	from to	
Clay	0	24
Sand - p clay	24	36
Black Mud	36	97
Sand - Mud	97	123
Sand	123	146

CODED

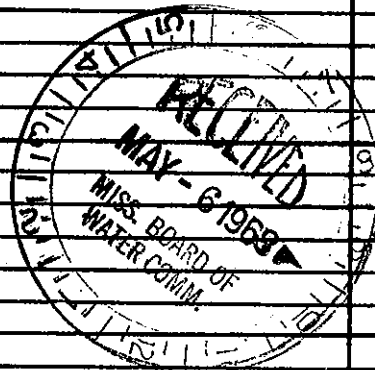

DRILLERS REMARKS: