

HOLMES MISSISSIPPI BOARD OF WATER COMMISSIONERS

W 2000
4-18-61

WATER WELL DRILLERS LOG

Date: 4/18, 1961, Driller: M^c Kay Mullins County Madison

(1) Owner of Land: <u>Fulton Hanna</u> (Name) <u>Lickens Miss</u> (Address)	Description & Color of Materials Sand, Clay, Red Clay, Shell, etc. Red clay white Sand Sinks to clay Brown clay Brown clay and Sand Brown Sand mud.	Thick- ness Feet 0 21 42 63 84 105 126	Depth Feet 21 42 63 84 105 126 147
(2) Location: $\frac{1}{4}$, $\frac{1}{4}$, Sec. <u>36 T.13 R.35</u> <u>4</u> miles <u>N.E.</u> of <u>Lickens</u> (distance) (direction) (Nearest Town)			
(3) Topography: <input checked="" type="checkbox"/> (Hilly) <input type="checkbox"/> (Flat) <input type="checkbox"/> (Level)			
(4) Purpose of Well: <u>Home</u> (Domestic Irrigation Municipal, Industrial, Other)			

Information upon completion of well:

(1) Diameter 2 inches. rod

(2) Total Depth 147 feet. 147

(3) Water Level 60ft feet below top of ground. 10

(4) Cased to _____, Size _____


(5) Screen: Size 20 6, Length 10ft

(6) Were any formations sealed against pollution?
_____ yes, no.

If YES depth of formation _____

Why _____

Drillers Remarks: _____

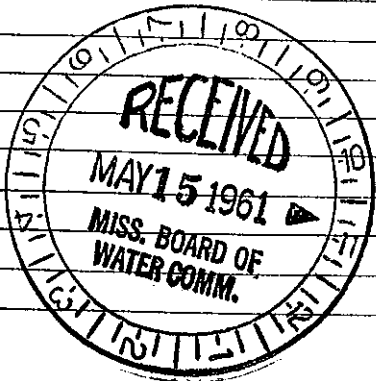

Well No.

(Use Back Side)

Mail this copy to Board of Water Commissioners 429 Miss. St. Jackson, Miss