

HOLMES
X5

MISSISSIPPI BOARD OF WATER COMMISSIONERS

5-28-63

WATER WELL DRILLERS LOG

CODED

Date: 5/28, 1963, Driller: M Kay County Holmes

(1) Owner of Land: A Criswell (Name)

Goodman Miss (Address)

(2) Location: 1/4, 1/4, Sec. 8 T13R4E

3 miles N of Goodman (distance) (direction) (Nearest Town)

(3) Topography: (Hilly) (Flat) (Level)

(4) Purpose of Well: Home (Domestic Irrigation Municipal, Industrial, Other)

Description & Color of Materials Sand, Clay, Red Clay, Shell, etc.	Thick- ness Feet	Depth Feet
Red Sandy Clay	0	21
" " "	21	42
Blue Sandy Clay	42	63
" " "	63	84
" " "	84	105
Brown Clay	105	126
" " "	126	147
" " "	147	231
Mid Sand Clay	231	252
" " "	252	253

Information upon completion of well:

(1) Diameter 2 inches.

(2) Total Depth 252 feet.

(3) Water Level 54 feet below top of ground.

(4) Cased to _____, Size _____

(5) Screen: Size 007, Length 10ft.

(6) Were any formations sealed against pollution?

yes, no.


If YES depth of formation _____

Why _____

Drillers Remarks: _____

1/2 HP Jet Pump

CODED

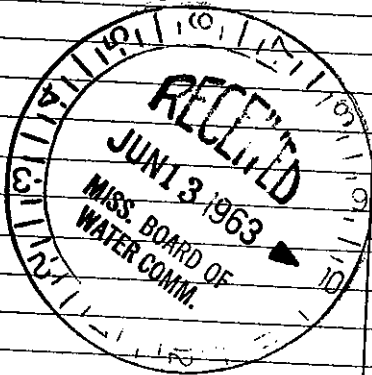

Well No.

(Use Back Side)

Mail this copy to Board of Water Commissioners 429 Miss. St. Jackson, Miss.