

Holmes
X 30
4-67

MISSISSIPPI
BOARD OF WATER COMMISSIONERS
416 North State Street
Jackson, Mississippi 39201

CODED

WATER WELL DRILLERS LOG

4-28 1967 Jack Martin Holmes
date well completed firm name county well located


LANDOWNER: Ruby Mae Moss
Goodman
Rt
(mailing address)

WELL LOCATION:
sec. 5 T 13 N R 4 E
S W
2 miles N of Goodman
(distance) (direction) (nearest town)

WELL PURPOSE: Home
(home, irrigation, municipal, industrial)

WELL COMPLETION DATA:
(1) diameter (inches) 2
(2) total depth (feet) 236
(3) static water level (feet) 70 below top of ground.
(4) casing Steel pipe 231,
(material) (depth)
2 If telescope see back.
(size)
(5) screen 5, 231
(length) (depth to top)
2, Stainless Steel
(size) (material)
(6) pump 1 7
(HP) (yield gpm)
Elec
(type power)
(7) electric log no
(yes or no)
(organization running log)
(8) how well bottom plugged Cap

description of formations encountered	from	to
Clay	0	17
Pipe clay	17	23
Black mud	23	62
Fine sand	62	78
Mud	78	85
CD Fine sand	85	100
Mud + Sand	100	130
Mud	130	222
Sand	222	236

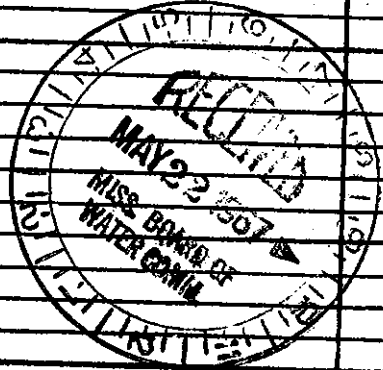

DRILLERS REMARKS: