

MISSISSIPPI BOARD OF WATER COMMISSIONERS

HOLMES

X ~~2000~~ WATER WELL DRILLERS LOG

Date: Nov 24, 1961, Driller: M. C. Kay Drilling County Holmes
 (Name)

(1) Owner of Land:	Description & Color of Materials Sand, Clay, Red Clay, Shell, etc.	Thick- ness Feet	Depth Feet
<u>Jack Albin</u> (Name)	<u>Clay</u>	<u>0</u>	<u>21</u>
<u>Goodman Min.</u> (Address)	<u>Red Sand Clay</u>	<u>21</u>	<u>32</u>
(2) Location: <u>13 14 36</u> <u>18</u> <u>T14</u> <u>R1E</u>	<u>Coarse White Sand</u>	<u>32</u>	<u>42</u>
<u>2</u> miles <u>S</u> , off <u>Goodman</u> (distance) (direction) (Nearest Town)	<u>Brown Sand</u>	<u>42</u>	<u>63</u>
(3) Topography: <input checked="" type="checkbox"/> (Hilly) <input type="checkbox"/> (Flat) <input type="checkbox"/> (Level)	<u>Brown yellow Sand</u>	<u>63</u>	<u>84</u>
(4) Purpose of Well: <u>Home</u> (Domestic Irrigation Municipal, Industrial, Other)	<u>Brown Sand</u>	<u>84</u>	<u>105</u>
	<u>Sand and Clay</u>	<u>105</u>	<u>126</u>
	<u>Sand Clay and Rock Str.</u>	<u>126</u>	<u>147</u>
	<u>Clay Sand Str.</u>	<u>147</u>	<u>168</u>
	<u>Clay Sand</u>	<u>168</u>	<u>189</u>
	<u>med Blue Sand</u>	<u>189</u>	<u>210</u>
	<u>Med to Coarse Sand</u>	<u>210</u>	<u>231</u>
	<u>Med to Coarse Sand</u>	<u>231</u>	<u>243</u>

Information upon completion of well:


- (1) Diameter 2 x 1/4 inches.
- (2) Total Depth 243 feet.
- (3) Water Level 23 feet below top of ground.
- (4) Cased to _____ Size _____
- (5) Screen: Size 1/4 (90%) Length 10ft
- (6) Were any formations sealed against pollution?
 _____ yes, _____ no.

Set Screen
insert screen 1/4
Shallow Well Pump

If YES depth of formation _____

Why _____

Drillers Remarks: _____

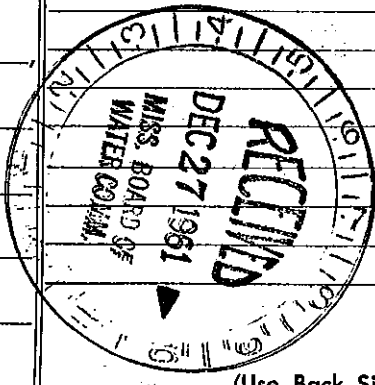

(Use Back Side)

Well No. _____

Mail this copy to Board of Water Commissioners 429 Miss. St. Jackson, Miss