

Humphreys  
A 6  
5-14-74

MISSISSIPPI  
BOARD OF WATER COMMISSIONERS  
416 North State Street  
Jackson, Mississippi 39201 CODED

WATER WELL DRILLERS LOG

MAY 14, 74 19 DYER WELL & IRRIGATION SERVICE Humphreys  
date well completed firm name county well located

LANDOWNER:	description of formations encountered	from	to
BOYCE ROLAND			
ISOLA, MISS.	SAND + PEA ROCK	19	40
(mailing address)	COARSE SAND, PEA ROCK, + GRAVEL	40	118

WELL LOCATION:  
sec. 21 T. 17 N. R. 3 W.  
6 1/2 miles N.E. of ISOLA  
(distance) (direction) (nearest town)

WELL PURPOSE: FOR FISH  
(home, irrigation, municipal, industrial)

WELL COMPLETION DATA:

(1) diameter (inches) 16"

(2) total depth (feet) 118'

(3) static water level (feet) 17' below top of ground.

(4) casing BUR IR 118' (material) (depth)  
16" (size) if telescope see back.

(5) screen 40' 78' (length) (depth to top)  
16" BUR IN BOT (size) (material)

(6) pump 60 3000 (HP) (yield gpm)  
DIESEL (type power)


(7) electric log No (yes or no)

(organization running log)

(8) how well bottom plugged PLATE

DRILLERS REMARKS:

CODED

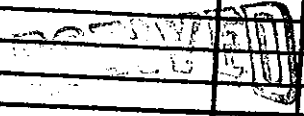

NOV 21 1974

MISS. BD. OF WATER COMM