

CODED
CODED

MISSISSIPPI
BOARD OF WATER COMMISSIONERS
416 North State Street
Jackson, Mississippi 39201

WATER WELL DRILLERS LOG

Humphreys
A9
1-68

1-31 1968 Dyerwell Inc. Humphreys
date well completed firm name county well located


LANDOWNER:
FLOYD ANDERSON
R.R. INVERNESS, MISS.
(mailing address)

WELL LOCATION:
sec. 15 T. 17 N R. 3 E
6 miles EAST of INVERNESS
(distance) (direction) (nearest town)

WELL PURPOSE:
(home, irrigation, municipal, industrial)

WELL COMPLETION DATA:
(1) diameter (inches) 3" x 2"
(2) total depth (feet) 1077
(3) static water level (feet) Flow below top of ground. 2" GALV.
(4) casing 3" BLU 1055' (material) (depth)
(size) If telescope see back.
(5) screen 20' 1055' (length) (depth to top)
2" STAINLESS STEEL (size) (material)
(6) pump 1 (HP) 18 (yield gpm)
ELEC. (type power)
(7) electric log No. (yes or no)
(organization running log) BACIC WASIT
(8) how well bottom plugged VALVE

| description of formations encountered | from | to |
|---------------------------------------|------|------|
| CLAY | 0 | 17 |
| SAND | 17 | 75 |
| GRAVEL | 75 | 182 |
| CLAY | 182 | 230 |
| SANDY SHALE | 230 | 315 |
| SAND | 315 | 402 |
| Gummy SHALE | 402 | 445 |
| SAND | 445 | 565 |
| CLAY & SHALE | 565 | 630 |
| GREEN SAND | 630 | 665 |
| SANDY SHALE | 665 | 677 |
| SHALE | 677 | 680 |
| SAND | 680 | 685 |
| Gummy SHALE | 685 | 765 |
| SAND | 765 | 810 |
| CLAY SHALE | 810 | 905 |
| SANDY SHALE | 905 | 939 |
| SHALE | 939 | 958 |
| Gummy SHALE | 958 | 990 |
| CLAY | 990 | 1039 |
| SAND | 1039 | 1077 |
| SAND & CLAY STRATICS | 1077 | 1100 |

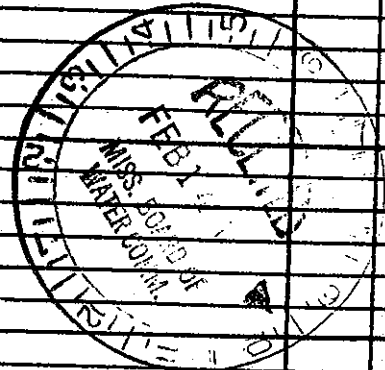

DRILLERS REMARKS: