

HUMPHREYS  
A 20  
8-5-80

MISSISSIPPI DEPARTMENT OF NATURAL RESOURCES

Bureau of Land and Water Resources

Southport Mall

P.O. Box 10631

Jackson, Mississippi 39209

WATER WELL DRILLERS LOG

**CODED**

08/05 1980 Larry's Well & Pump Humphreys  
 date well completed firm name county well located

LANDOWNER: Wayne King

description of formations encountered

from to

Belzoni, Mo  
 (mailing address)

clay 0 22  
fine sand 22 40  
med sand 40 60  
course sand & gravel 60 116'


WELL LOCATION:

sec 22 T 17 N R 3 W  
10 miles N of Belzoni  
 (distance) (direction) (nearest town)

WELL PURPOSE: Fish Pond  
 (home, irrigation, municipal, industrial)

WELL COMPLETION DATA:

- (1) diameter (inches) 12"
- (2) total depth (feet) 116'
- (3) static water level (feet) 13 below top of ground
- (4) casing Steel, 76'  
(material) (depth)  
 (size) if telescope see back.
- (5) screen 40', 76'  
(length) (depth to top)  
12", Steel  
(size) (material)
- (6) pump 4<sup>1/2</sup> 2000  
(HP) (yield gpm)  
D  
(type power)
- (7) electric log No  
(yes or no)  
(organization running log)
- (8) how well bottom plugged steel  
Plate

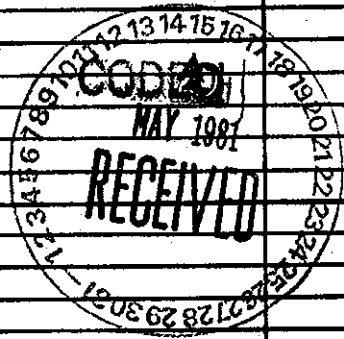

DRILLERS REMARKS: