

MISSISSIPPI DEPARTMENT OF NATURAL RESOURCES

Bureau of Land and Water Resources

Southport Mall

P.O. Box 10631

Jackson, Mississippi 39209 **CODED**

WATER WELL DRILLERS LOG

Humphreys
A28
5-5-81

USE
- 1022

date well completed May 05 1981 well name Larry's well & pump county well located Humphreys

LANDOWNER: <u>Johnny Rowland</u>	description of formations encountered	from	to
<u>Inverness Mo</u> (mailing address)			
	<u>Fine sand</u>	<u>30</u>	<u>60</u>
	<u>Coarse sand</u>	<u>60</u>	<u>114</u>
WELL LOCATION: sec. <u>29</u> T. <u>17</u> N R. <u>3</u> E <u>8</u> miles <u>SE</u> of <u>Inverness</u> (distance) (direction) (nearest town)			
WELL PURPOSE: <u>Fish Pond</u> (home, irrigation, municipal, industrial)			
WELL COMPLETION DATA: (1) diameter (inches) <u>16"</u> (2) total depth (feet) <u>114'</u> (3) static water level (feet) <u>23</u> below top of ground. CODED (4) casing <u>Steel</u> , <u>74'</u> (material) (depth) <u> </u> if telescope see back. (size) (5) screen <u>40'</u> , <u>74'</u> (length) (depth to top) <u>16"</u> , <u>Steel</u> (size) (material) (6) pump <u> </u> (HP) <u> </u> (yield gpm) <u> </u> (type power) (7) electric log <u>No</u> (yes or no) <u> </u> (organization running log) (8) how well bottom plugged <u>Steel Plate</u>			
DRILLERS REMARKS:			


DEPT. OF NATURAL RESOURCES
BUREAU OF LAND & WATER RESOURCES

JUL 16 1981

RECEIVED

If well telescopes please sketch and show depths.

GROUND LEVEL

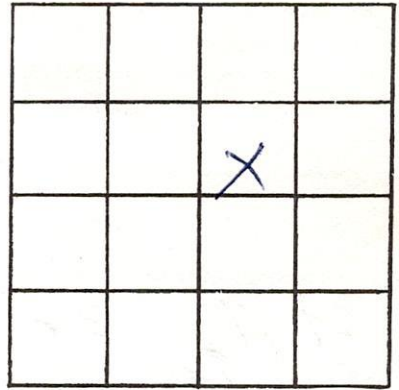

SECTION 29

Please indicate well location X.

ADDITIONAL INFORMATION

If more than one screen, show locations of each on sketch.