
S.	tota Wall Danart			
	Part 1	For Office Use Only:		
County: Humphreys Mississippi De	epartment of Environmental Quality	Aquifer:		
	of Land and Water Resources	Well #: <u>A-65</u>		
1 Driller:	P.O. Box 10631 ickson, MS 39289-0631	L. S. Elevation:		
Date drilling completed: $6-10-05$	(601)961-5210			
	(601)354-6938 (fax)	E-log #:		
State Law requires that this report be prepare 30 days of completion of drilling of the well.	d by the driller in detail and filed	with the Department within		
Well Owner Information		ell Location		
Owner NameWalter Johnson	33 33 5. Latitude:^	,6 90 32 47.1 "Longitude:°"		
Mailing Address: Rt.1, Box 95-A	Method of Lat/Long (circle	one): Conventional Survey,		
	USGS guad, Hand-he	ld GPS, Survey-grade GPS		
Inverness, MS 3875	$\frac{1}{3} \qquad \frac{\text{SE}}{4} \frac{\text{SE}}{4} \frac{1}{4} \frac{\text{SE}}{4} \frac{1}{4} \frac{1}{4$	8 <u>Twn 17N Rng 3W</u>		
City State Zip Co	de Distance Direction			
Telephone No. ()	5 Miles SE	of Inverness		
	Well Data			
Purpose of Well (circle one) Home Industrial Public				
Date well drilling started:6-10-05	Date well drilling completed:	6-10-05		
If flowing, method of flow regulation: Valve	Other (describe)			
Static Water Level:42feet above or below ci	rcle one) land surface Date measured	<u> </u>		
Method of Measurement (circle one) steel tape electric tape air line other.				
Hole depth: <u>117</u> Well depth: <u>117</u> Well grouted to a depth of <u>10</u> feet				
Type of grout (circle one): Cement Bentonite	Mix			
Casing length: <u>77</u> feet Casing diameter.	12 inches Type of casing:	PVC 160		
Screen length: <u>40</u> feet Screen diameter:	<u>12</u> inches Type of screen:	PVC 160		
Screen slot size: 050 inches Setting depth	: From <u>78</u> feet to	<u>117</u> feet		
Type of completion (circle all applicable): Gravel packed	Type of completion (circle all applicable): Gravel packed Underreamed Telescoped Open hole Natural Development			
Other (describ	e):			
Top of lap pipe or reduction in casing:	feet. If telescoped or more than one so	reen, describe on back of name		
Logs run (circle all applicable): No log run Electric Ga	-			
Name of organization running log(s):	· · · · · · · · · · · · · · · · · · ·			
I certify that the well was drilled, constructed, and completed in accordance with all applicable requirements of the Mississippi				
Department of Environmental Quality and/or the Missis	ssippi Department of Health regulation	ns and state laws.		
Irrigation Equipment Inc. Patrick M. Chism 0695	Patril 1	Mchini		
Print Name of Water Well Contractor and License No.	Signature	of Water Well Contractor		
	Signature			

JUN 2 9 2005 BY: OLWR If well telescopes please sketch below and show depths.

Ground Level

	A-65
Description of Formations Encountered	From To
Clay	0 15
Fine Sand	16 65
Coarse Sand/gravel	66 117

If more than one screen, show location of each on sketch

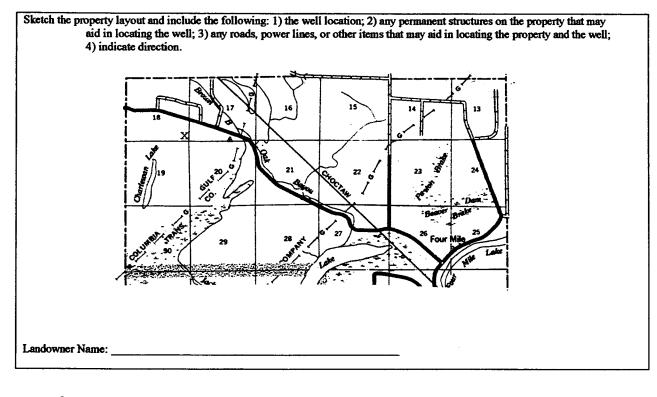

١ Signature of Water Well Contractor

County: Humphreys Permit #: 40443	Pump Installer Mississippi Departme Office of Land	ELL REPORT Part 2 So Completion Report and Water Resources For Office Use Only: Aquifer:	
Driller: Date completed:	(60)	Box 10631 MS 39289-0631 1)961-5210 54-6938 (fax) Elevation:	
This report should be prepared by installation of pump.	, the pump installer in det	ail and filed with the Department within 30 days of the	
Well Owner Inform	nation	Well Location	
Owner Name:	son	Latitude:Longitude:	
Mailing Address: Rt.1, Box	95-A	Method of Lat/Long (circle one): Conventional Survey,	
<u></u>		USGS quad, Hand-held GPS, Survey-grade GPS	
Inverness, City State	MS 38753 <b>zip Code</b>	$\frac{5E}{2} \frac{1}{2} \frac{5W}{4} \frac{3}{2} \frac{18}{2} \frac{18}{10} \frac{17N}{2} \frac{17N}{2} \frac{3W}{2}$	
Telephone No. ()		Distance         Direction         Nearest Town           5         Miles         SE of Inverness	
Pum p Type Circle one		Power Type Circle one	
Air Lift Jet	Submersible	Diesel Engine Gasoline Engine Natural Gas	
Bucket Piston	Curbing	Blectric Motor Hand Tractor PTO	
Centrifugal Rotary	Flowing Well	Windmill Other (specify):	
Other (specify):		Horse Power Rating of Motor:30	
Date Pump Installed:6-10	0-05	Setting Depth:60 feet	
Rated Pump Capacity: 1500	Gallons Per Minute	Number of Stages:2	
Pump Test Date		Method of Measuring Water Level Circle one	
Static Water Level (A):Fe	et Below Land Surface	Air Line       Electric Measuring Line       Steel Tape         Other (specify):	
Drawdown [(B) – (A)]:Feet Below Land Surface		For flowing well, measured shut in head:feet	
Cest Pumping Rate:Gallons Per Minute		Well yielded GPM with a drawdown of	
Duration of Pump Test (minimum 4 hour	s):hours	feet afterhours of pumping	
HEREBY CERTIFY that the above stat Patrick M. Chism	0695	Patrick M Chin	
Print Name of Pump Installer and Licens	e No. (11 applicable)	Signature of Pump Installer	

•

JUN 2 9 2005 BY: OLWR