

MISSISSIPPI DEPARTMENT OF NATURAL RESOURCES
Bureau of Land and Water Resources

P.O. Box 10631

Jackson, Mississippi 39209

WATER WELL DRILLERS LOG

COUNTY WELL LOCATED
Ham Thayer

WELL NUMBER CODED
A 2004

DATE WELL COMPLETED
7-20-87

PERMIT NUMBER

NAME OF DRILLING FIRM
Teared's Rig & Well

NAME & MAILING ADDRESS OF LANDOWNER
Charles Kelland
Belzoni Ms 39038
509 Wister Dr.

WELL LOCATION: SEC 32 TOWNSHIP 17^N RANGE 3^E

DISTANCE DIRECTION NEAREST TOWN
5 Miles NE of Isole

OTHER LANDMARK

WELL PURPOSE Home Irrigation, Municipal, Industrial, Fish Pond, etc.

PUMP DATA

PUMP TYPE (Circle One):
 Submersible, Turbine, Jet, Flowing Well,
Other (Describe) _____

POWER TYPE (Circle One):
 Electric, Tractor, Diesel, Gasoline, Butane,
Other (Describe) _____

Pump Capacity (GPM)	No. of Stages	Setting Depth
<u>20</u>	<u>10</u>	<u>63'</u> FT.

PUMP TEST

Well yielded 20 GPM with
a drawdown of 37 ft.
after 1 hours of pumping

WELL DATA

Well Depth <u>700</u>	Casing Diameter (In.) <u>4x2</u>	Casing Length (Ft.) <u>660'</u>
Type of Casing <u>NVC</u>	Hole Depth <u>700</u>	Depth to Static Water Level <u>33</u>

TYPE OF COMPLETION: (Circle One or More)
Gravel Packed, Underreamed, Telescoped,
Natural Development, Open Hole, Other

Top of Lap Pipe or Reduction in Casing
140 FEET IF TELESCOPED OR MORE THAN ONE SCREEN: USE BACK PAGE

LOG DATA

TYPE OF LOG RUN (Circle One):
Electric, Gamma Ray, Density, Sonic, No Log Run, Neutron,
Other (Describe) _____

Name of Organization Running Log


SCREEN DATA

Diameter - Inches <u>2"</u>	Length - Feet <u>40</u>	Slot Size - Inches <u>.010</u>
Screen Type <u>NVC</u>	Depth to Bottom - Feet <u>640 to 700</u>	

GEOLOGIC DATA (Office Use Only)

Surface Elev.	Geologic Unit	Unit Thickness	Depth to Top
Subs. SWL	Date	Analysis	Aquifer Test

Driller's Remarks

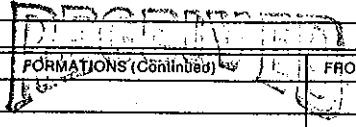

DESCRIPTION OF FORMATIONS ENCOUNTERED	FROM	TO	FORMATIONS (Continued)	FROM	TO
<u>Sand "st"</u>	<u>600</u>	<u>700</u>			

Department of Natural Resources
Bureau of Land & Water Resources

IF MORE SPACE IS NEEDED, USE BACK