

HUMPHREYS

B5

4-17-57

MISSISSIPPI BOARD OF WATER COMMISSIONERS

WATER WELL DRILLERS LOG

CODED

9/24/65
C 398

Date: April 17, 1957, Driller: Layne-Central Company, Humphries

(Name)

(1) Owner of Land: George W. John

(Name)

Belzoni, Mississippi

(Address)

(2) Location: 1/4, 31, 1/4, Sec. 32 T6 R7

8 miles west of Belzoni

(distance)

(direction)

(Nearest Town)

(3) Topography: flat

(Hilly)

(Flat)

(Level)

(4) Purpose of Well: irrigation

(Domestic Irrigation
Municipal, Industrial, Other)

Description & Color of Materials Sand, Clay, Red Clay, Shell, etc.	Thick- ness Feet	Depth Feet
Clay	18	18
Fine blue sand	14	32
Coarse blue sand & lignite	20	52
Coarse brown sand & pea rock	20	72
Sand & gravel	10	82
Sand & gravel	20	102
Log	2	104
Coarse sand & gravel	10	114

Information upon completion of well:

(1) Diameter 18x12 inches.

(2) Total Depth 114 feet.

(3) Water Level 13'6" feet below top of ground.

(4) Cased to 62', Size 18"
2' of 18" x 12" swage

(5) Screen: Size 12", Length 50'

(6) Were any formations sealed against pollution?

yes, no

If YES depth of formation


Why

Drillers Remarks:

2610 GPM.

Electric power.

CODED

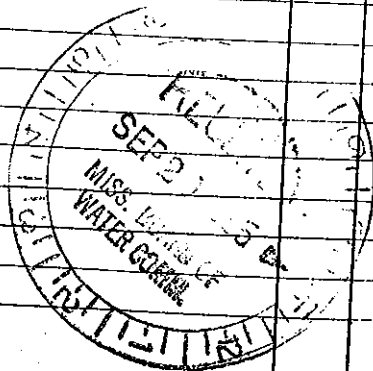

Well No.

(Use Back Side)

Mail this copy to Board of Water Commissioners 429 Miss. St. Jackson, Miss