

HUMPHREYS MISSISSIPPI BOARD OF WATER COMMISSIONERS

B 11  
7-31-60

WATER WELL DRILLERS **CODED**

Date: 7-31, 1960, Drillers: BUTANE GAS CO. OF 6-WOOD County ITAWAMPA  
(Name)

(1) Owner of Land: <u>G. B. MORTIMER</u> (Name)	Description & Color of Materials Sand, Clay, Red Clay, Shell, etc.	Thick- ness Feet	Depth Feet
<u>BEZZONI, MISS.</u> (Address)	<u>CLAY (BACKSHOT)</u>	<u>31</u>	<u>31</u>
(2) Location: <u>1/4, 1/4, Sec. 13 T16R9</u>	<u>SAND (SILT)</u>	<u>9</u>	<u>40</u>
<u>4</u> miles <u>SOUTH</u> , of <u>ISOLA</u> (distance) (direction) (Nearest Town)	<u>GREEN SAND</u>	<u>19</u>	<u>59</u>
(3) Topography: <u>LEVEL</u> (Hilly) (Flat) (Level)	<u>GREEN SAND PEA ROCK</u>	<u>12</u>	<u>71</u>
(4) Purpose of Well: <u>IRRIGATION</u> (Domestic Irrigation Municipal, Industrial, Other)	<u>ROCK (GRAVEL)</u>	<u>13</u>	<u>84</u>
	<u>SAND (QUICK)</u>	<u>7</u>	<u>91</u>
	<u>GREEN SAND</u>	<u>15</u>	<u>106</u>

**CODED**


Information upon completion of well:

- (1) Diameter 16 inches.
- (2) Total Depth 106 feet.
- (3) Water Level 18 feet below top of ground.
- (4) Cased to 66, Size 16"
- (5) Screen: Size 12", Length 40'
- (6) Were any formations sealed against pollution?  
yes, X no.

If YES depth of formation \_\_\_\_\_

Why \_\_\_\_\_

Drillers Remarks: NONE

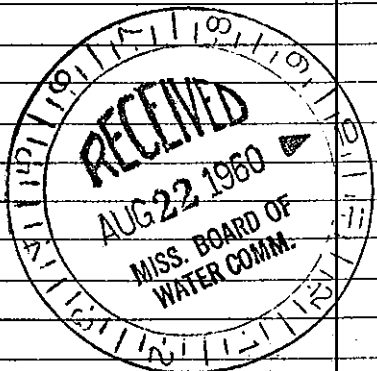

Well No.

(Use Back Side)