

HUMPHREYS MISSISSIPPI BOARD OF WATER COMMISSIONERS


B 20
7-22-63

coded

WATER WELL DRILLERS LOG

Date: JULY 22, 1963, Driller: DELTA DRILLING Co. County HUMPHREY
(Name)

	Description & Color of Materials Sand, Clay, Red Clay, Shell, etc.	Thick- ness Feet	Depth Feet
(1) Owner of Land: <u>MRS. WA. SWITZER</u> (Name)	GUMBO	21	21
<u>1506A, MISS. PHONE. 222-13</u> (Address)	SAND	25	46
(2) Location: <u>SE 1/4, NW 1/4, Sec. 27-N. T. 16-R. 11-W</u>	GRAVEL	7	120
_____ miles _____ of _____ (distance) (direction) (Nearest Town)	SAND	40	160
(3) Topography: _____ (Hilly) (Flat) (Level)	GUMBO	100	261
(4) Purpose of Well: <u>DOMESTIC</u> (Domestic Irrigation Municipal, Industrial, Other)	SHALE	102	363
Information upon completion of well:	GUMBO	20	383
(1) Diameter <u>4</u> inches.	SHALE	88	471
(2) Total Depth <u>802</u> feet.	SAND	50	521
(3) Water Level <u>13</u> feet below top of ground.	SHALE W/ ROCK	40	561
(4) Cased to <u>772</u> , Size <u>100' 4" 1 1/2" 2"</u>	SAND W/ 1/4" ROCK.	40	601
(5) Screen: Size <u>2"</u> , Length <u>10'</u> STAINLESS ST	SHALE	61	662
(6) Were any formations sealed against pollution? _____ yes, _____ no.	GUMBO	20	682
If YES depth of formation _____	SHALE	20	702
Why _____	SAND	80	782
Drillers Remarks: <u>3/4 H.P. RED JACKET</u> <u>DEEP WELL SUMMERSIBLE</u> <u>PUMP SET IN WELL - 20' 2"</u> <u>TAIL PIPE SET ON BOTTOM</u> <u>END OF WELL</u>	SHALE	10	792
	GUMBO -	10	802

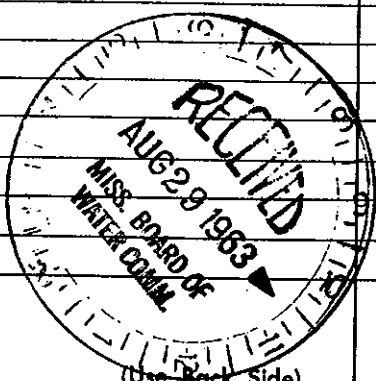

Well No.

Mail this copy to Board of Water Commissioners 429 Miss. St. Jackson, Miss.