

15th DYER WELL TR. SEC. CODED

HUMPHREYS
B 26
8-5-68

MISSISSIPPI
BOARD OF WATER COMMISSIONERS
416 North State Street
Jackson, Mississippi 39201

CODED CODED

JED

WATER WELL DRILLERS LOG

8-5 1968 S.O. THARP Humphreys
date well completed firm name county well located


LANDOWNER: S.O. THARP
P.R. ISOLA
(mailing address)

WELL LOCATION:
sec. 25 T. 16 N R. 4 W
5 miles WEST of BELZON
(distance) (direction) (nearest town)

WELL PURPOSE: Home
(home, irrigation, municipal, industrial)

WELL COMPLETION DATA:
(1) diameter (inches) 2"
(2) total depth (feet) 874'
(3) static water level (feet) 14" below top of ground.
(4) casing (material) (depth) 854'
2" if telescope see back.
(5) screen 20' 854'
(length) (depth to top)
2" STAINLESS
(size) (material)
(6) pump 1/2 HP 15
(HP) (yield gpm)
ELEC
(type power)
(7) electric log NO
(yes or no)
(organization running log)
(8) how well bottom plugged Valve

description of formations encountered	from	to
CLAY	0	12
SAND	12	85
GRAVEL	85	135
CLAY	135	164
SANDY SHALE	164	202
SAND	202	275
Gummy SHALE	275	390
SAND	390	397
CLAY	397	367
SAND	367	398
SANDY SHALE ST.	398	442
SAND	442	479
ROCK	479	480
SANDY SHALE	480	557
ROCK	557	558
CLAY	558	563
SHALE & ROCK	563	635
Gummy SHALE	635	810
ROCK	810	811
Gummy SHALE	811	819
SAND	819	874
SAND ST.	874	880

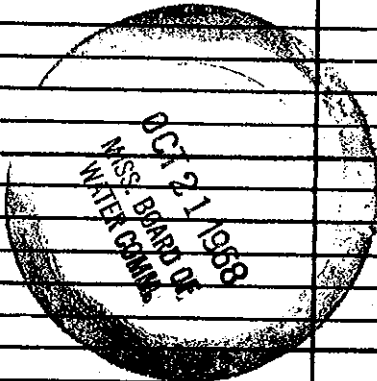

DRILLERS REMARKS: