

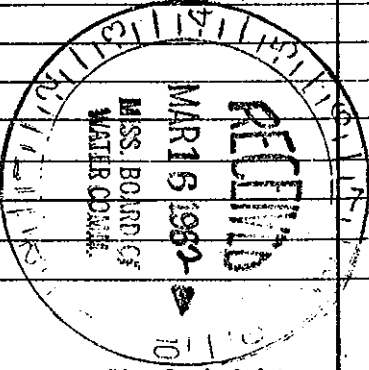
HUMPHREYS MISSISSIPPI BOARD OF WATER COMMISSIONERS

QB44

WATER WELL DRILLERS LOG **CODED**

2-1-62

Date: Feb 1, 1962, Driller: J.P. Minyard County Humphreys
(Name)

(1) Owner of Land: <u>R.L. Hoke</u> (Name)	Description & Color of Materials Sand, Clay, Red Clay, Shell, etc.	Thick- ness Feet	Depth Feet
<u>Isola - Miss</u> (Address)	Soil	17	0-17
(2) Location: <u>1/4, 1/4, Sec. 24 16 R 5</u>	Sand		17-25
<u>8</u> miles <u>NW</u> , of <u>Belzoni</u> (distance) (direction) (Nearest Town)	Sand streaked with Gumbo		25-125
(3) Topography: <u>K</u> (Hilly) (Flat) (Level)	Sand		125-257
(4) Purpose of Well: <u>Domestic</u> (Domestic Irrigation Municipal, Industrial, Other)	Sand streaked with Gumbo		257-325
Information upon completion of well:	Sand		325-410
(1) Diameter <u>3"</u> inches. <u>1st Line casing</u> <u>2" Bottom casing</u>	Gumbo streaked with sand		410-475
(2) Total Depth <u>1010</u> feet.	Shale Gumbo		475-539
(3) Water Level <u>12</u> feet below top of ground.	Sandy shale		539-601
(4) Cased to <u>1010</u> , Size <u>3" x 2"</u>	Shale Gumbo		601-663
(5) Screen: Size <u>2"</u> , Length <u>20'</u>	Sand streaked with Gumbo		663-760
(6) Were any formations sealed against pollution? <u>K</u> yes, <u>no.</u>	Sandy shale		760-912
If YES depth of formation <u>475</u>	Gumbo streaked with sand		712-980
Why <u>Case off Upper Hard Water Aquifer</u>	Sand		980-1010
Drillers Remarks:	CODED		
			
	(Use Back Side)		
	Well No.		

Mail this copy to Board of Water Commissioners 429 Miss. St. Jackson, Miss