

HUMPHREYS MISSISSIPPI BOARD OF WATER COMMISSIONERS

B 48
1-65

WATER WELL DRILLERS LOG **CODED**

Date: 1-, 1965, Driller: DAVID BERRY County YAZOO

CLARENCE LOW TOWERY (Name)

(1) Owner of Land: B. H. Jones
(Name)
ISOLA MISS
(Address)

(2) Location: 1/4, 1/4, Sec. 23 T 16 R 5
4 miles West, of Osola
(distance) (direction) (Nearest Town)

(3) Topography: Flat
(Hilly) (Flat) (Level)

(4) Purpose of Well:
(Domestic Irrigation
Municipal, Industrial, Other)

Description & Color of Materials Sand, Clay, Red Clay, Shell, etc.	Thick- ness Feet	Depth Feet
Clay	18	18
Clay	10	28
Sand	70	98
gravel	20	118
gravel	20	138
gravel	10	148
clay with sand beds		
Clay	10	158
Clay with sand beds	20	178
Sand	20	198
Sand	20	218
Sand with clay beds	20	238
Sand	12	250
Clay CODED	8	258
Clay	20	278
Clay with sand beds	20	298
Sand with clay beds	20	318
Sand with clay beds	20	338
Sand	20	358
Sand	20	378
Sand	20	398
Hardy Shale	20	418
fine sand	20	438
Sand	20	458
Sand	20	478
Sand with shale beds	20	498
Hardy Shale	20	518
Sand	23	752
Shale	6	758
Sand	20	778
Sand	24	802
Shale	50	852.3
Shale with sand beds	21	873.1
Shale	20.5	893.6
Shale with sand	20.4	914

Information upon completion of well:

(1) Diameter 4 1/2 inches.

(2) Total Depth 911 feet.

(3) Water Level 25 feet below top of ground.

(4) Cased to _____, Size _____


(5) Screen: Size 2", Length 30 ft.

(6) Were any formations sealed against pollution?
_____ yes, _____ no.

If YES depth of formation _____

Why _____

Drillers Remarks: _____

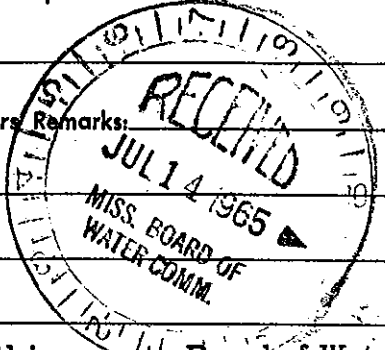

Mail this copy to Board of Water Commissioners 429 Miss. St. Jackson, Mis: