


HUMPHREYS MISSISSIPPI BOARD OF WATER COMMISSIONERS

B 49
4-5-65

WATER WELL DRILLERS LOG **CODED**

Date: 4-5, 1965, Driller: David Bony County Yazoo
(Name)

(1) Owner of Land: <u>Hadley Castle</u> (Name)	Description & Color of Materials Sand, Clay, Red Clay, Shell, etc.	Thick- ness Feet	Depth Feet
<u>Osola, Miss.</u> (Address)	Clay	28	28
(2) Location: <u>1/4, 1/4, Sec. 11 T6 R7W</u>	sand	30	58
_____ miles _____ of _____ (distance) (direction) (Nearest Town)	gravel	40	98
(3) Topography: <u>Plot</u> (Hilly) (Flat) (Level)	sand	20	118
(4) Purpose of Well: <u>D</u> (Domestic Irrigation, Municipal, Industrial, Other)	gravel	20	138
Information upon completion of well:	Clay	60	198
(1) Diameter: <u>4x2</u> inches.	sand (with) clay	40	238
(2) Total Depth: <u>820</u> feet.	sand	72	312
(3) Water Level: <u>15</u> feet below top of ground.	Shale	28	338
(4) Cased to: <u>788</u> , Size <u>4x2</u>	Shale (with) sand	40	378
(5) Screen: Size <u>2"</u> , Length <u>40</u>	sand (with) shale	20	398
(6) Were any formations sealed against pollution? _____ yes, _____ no.	Shale	40	438
If YES depth of formation _____	Sandy shale	40	478
Why _____	Sand fine	40	518
Drillers Remarks: _____	Shale (with) sand	80	598
	Shale	20	618
	sand	20	638
	Shale	20	658
	Shale	90	748
	fine sand	30	778
	sand fine	20	798
	sand good	20	818

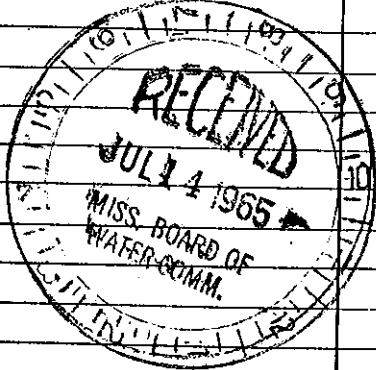

Well No.

(Use Back Side)

Mail this copy to Board of Water Commissioners 429 Miss. St. Jackson, Miss.