

HUMPHREYS

MISSISSIPPI BOARD OF WATER COMMISSIONERS

B 44
4-18-57

WATER WELL DRILLERS LOG

COPIED
9/24/65
404

Date: April 18, 1957, Driller: Layne-Central Company, Humphries

(Name)

(1) Owner of land: L. E. Grant

(Name)

Isola, Mississippi

(Address)

(2) Location: 1/4, 1/4, Sec. 26 T16 R14

3/4 miles east Sunflower River of (Nearest Town)

(3) Topography: flat

(Hilly) (Flat) (Level)

(4) Purpose of Well: irrigation

(Domestic Irrigation
Municipal, Industrial, Other)

Description & Color of Materials Sand, Clay, Red Clay, Shell, etc.	Thick- ness Feet	Depth Feet
Clay	25	25
Fine sand	9	34
Coarse sand	8	42
Coarse sand, pea	57	99
Coarse sand, big rocks	3	102

Information upon completion of well:

(1) Diameter 18x12 inches.

(2) Total Depth 102 feet.

(3) Water Level 17' 4" feet below top of ground.

(4) Cased to 48' 3" Size 12" 2' of 18" x 12" swage

(5) Screen: Size 50', Length 12"

(6) Were any formations sealed against pollution?

no no.


If YES depth of formation

Why

Drillers Remarks:

2444 GPM.

Electric power.

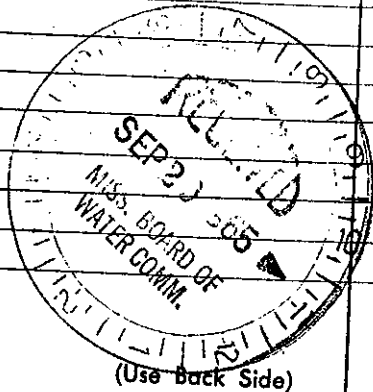

Well No.

Mail this copy to Board of Water Commissioners 429 Miss. St. Jackson, Miss.