

Humphreys
E 67
8-66

MISSISSIPPI BOARD OF WATER COMMISSIONERS

CODED

WATER WELL DRILLERS LOG

Date: 8-10, 1966, Driller: Butane Gas Co. County: Humphreys
(Name)

(1) Owner of Land: S.O. Marx
(Name)
Belzoni, Miss.
(Address)

(2) Location: NE 1/4, SW 1/4, Sec. 25 T16 R44
5 miles W of Belzoni
(distance) (direction) (Nearest Town)

(3) Topography: Flat
(Hilly) (Flat) (Level)

(4) Purpose of Well: Irrigation
(Domestic Irrigation
Municipal, Industrial, Other)

Description & Color of Materials Sand, Clay, Red Clay, Shell, etc.	Thick- ness Feet	Depth Feet
<u>Clay</u>	<u>13</u>	<u>13</u>
<u>"</u>	<u>"</u>	<u>"</u>
<u>Fine Sand</u>	<u>10</u>	<u>23</u>
<u>"</u>	<u>10</u>	<u>33</u>
<u>Coarse Sand - Gravel</u>	<u>10</u>	<u>43</u>
<u>"</u>	<u>10</u>	<u>53</u>
<u>"</u>	<u>10</u>	<u>63</u>
<u>"</u>	<u>10</u>	<u>73</u>
<u>"</u>	<u>10</u>	<u>83</u>
<u>"</u>	<u>10</u>	<u>93</u>
<u>"</u>	<u>10</u>	<u>103</u>

Information upon completion of well:

(1) Diameter 12 inches.

(2) Total Depth 103 feet.

(3) Water Level 21 feet below top of ground.

(4) Cased to 63, Size 12


(5) Screen: Size 12, Length 40

(6) Were any formations sealed against pollution?
no yes, X no.

If YES depth of formation _____

Why _____

Drillers Remarks: _____

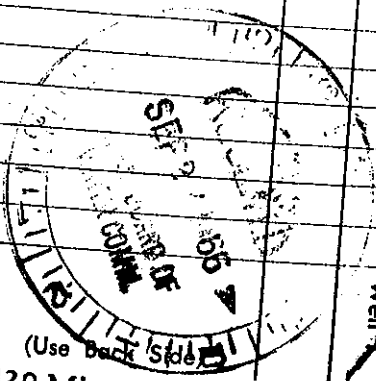

(Use Back Side)

Mail this copy to Board of Water Commissioners 429 Miss. St. Jackson, Miss.