

CODED

MISSISSIPPI  
BOARD OF WATER COMMISSIONERS  
416 North State Street  
Jackson, Mississippi 39201

WATER WELL DRILLERS LOG


Humphreys  
B68  
6-66

June 3 66 19 Butane Gas of Greenwood Humphreys  
date well completed firm name county well located

LANDOWNER:  
H. D. THARPE  
L 506 A. Miss  
(mailing address)  
WELL LOCATION:  
sec. 35 T 16 N R 4 E  
W  
4 miles S of Isola  
(distance) (direction) (nearest town)  
WELL PURPOSE: DOMESTIC  
(home, irrigation, municipal, industrial)

description of formations encountered	from	to
Clay	0	10
Coarse Sand + gravel	10	150
Shale	150	250
Shale with Sand Strata	250	440
Hard Shale	440	680
Stratified Sand + Shale	680	750
Blue Clay	750	800
Shale	800	870
White Sand	870	900

WELL COMPLETION DATA:  
(1) diameter (inches) 4" x 2"  
(2) total depth (feet) 900'  
(3) static water level (feet) 15' below top of ground. 4"-126'  
(4) casing STEEL 880'  
(material) (depth)  
4 1/2" If telescope see back.  
(size)  
(5) screen 20' 880'  
(length) (depth to top)  
2" STAINLESS STEEL  
(size) (material)  
(6) pump 1 1/2 25  
(HP) (yield gpm)  
Electric  
(type power)  
(7) electric log No  
(yes or no)  
(organization running log)  
(8) how well bottom plugged  
Bore Press Valve

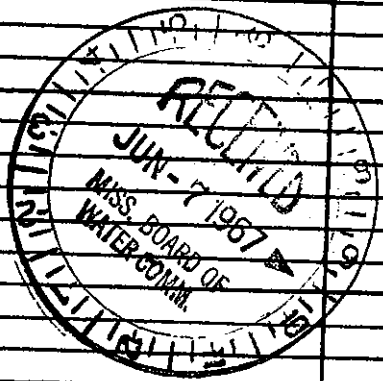

DRILLERS REMARKS: